


FOR INFORMATION ONLY

	MO 180 & PENNRIDGE-BOENKER	MO 180 & I-270 SB RAMP	MO 180 & I-270 NB RAMP	MO 180 & RTE B- MARESHHELL	MO 180 & DEPAUL CENTER	MO 180 & MCKELVEY	MO 180 & HILLTOP PLAZA	MO 180 & HARMONY	MO 180 & I-70 WB RAMP	MO 180 & I-70 EB RAMP	MO 180 & MARK TWAIN	MO 180 & FEE FEE	MO 180 & HOME DEPOT	MO 180 & 67-LINDBERGH SB RAMP	MO 180 & 67-LINDBERGH NB RAMP	MO 180 & NORTHWEST PLAZA	MO 180 & ADIE	MO 180 & CYPRESS	MO 180 & ST. TIMOTHY	MO 180 & ASHBY	MO 180 & SAN CARLOS	MO 180 & ST. GREGORY	MO 180 & GERALDINE-FIRE STATION	MO 180 & WISMER	MO 180 & LYNNTOWN	MO 180 & EDMUNDSON	MO 180 & WOODSON	MO 180 & ST. JOHN'S CROSSING	MO 180 & BROWN	MO 180 & MCKIBBON	MO 180 & I-170	MO 180 & LACKLAND	MO 180 & HANLEY	MO 180 & NORMANDY	MO 180 & SPUR-PENNSYLVANIA	MO 180 & FERGUSON	MO 180 & KINGSLAND-METRO	MO 180 & LUCAS & HUNT	MO 180 & OGDEN											
ATC TRAFFIC SIGNAL CONTROLLER	1																																																	
TRAFFIC SIGNAL VIDEO DETECTION SYSTEM (3 CAMERAS)		1																																																
TRAFFIC SIGNAL VIDEO DETECTION SYSTEM (4 CAMERAS)	1		1	1	1	1	1	1			1	1	1					1	1	1	1	1			1	1	1	1	1	1	1	1	1	1																
TRAFFIC SIGNAL ADVANCED DETECTION SYSTEM (2 UNITS)					1		1	1			1		1			1			1	1	1	1		1	1	1	1	1	1	1	1	1	1	1	1	1	1	1	1	1	1	1	1	1	1	1	1	1		
TRAFFIC SIGNAL ADVANCED DETECTION SYSTEM (3 UNITS)		1								1	1			1	1		1	1		1																														
TRAFFIC SIGNAL ADVANCED DETECTION SYSTEM (4 UNITS)	1		1	1		1						1															1		1		1	1	1	1	1															
REMOVAL OF IMPROVEMENTS	1	1	1	1	1	1	1	1	1	1	1	1	1			1	1	1	1	1	1	1	1	1	1	1	1	1	1	1	1	1	1	1	1	1	1	1	1	1	1	1	1	1	1	1	1	1	1	


*LINDBERGH NB AND SB RAMP JUNCTIONS SHARE A SINGLE CONTROLLER

TOTAL QUANTITIES			
ITEM NO.	ITEM DESCRIPTION	UNIT	QUANTITY
ROADWAY ITEMS			
616-99.01	LUMP SUM TEMPORARY TRAFFIC CONTROL	LS	1
618-10.00	MOBILIZATION	LS	1
SIGNAL ITEMS			
202-20.10	REMOVAL OF IMPROVEMENTS	LS	1
612-30.01	TRUCK OR TRAILER MOUNTED ATTENUATOR (TMA)	LS	1
902-99.01	TRAFFIC SIGNAL MAINTENANCE AND PROGRAMMING	LS	1
902-99.02	ATC TRAFFIC SIGNAL CONTROLLER	EA	38
902-99.03	TRAFFIC SIGNAL VIDEO DETECTION SYSTEM (3 CAMERAS)	EA	11
902-99.04	TRAFFIC SIGNAL VIDEO DETECTION SYSTEM (4 CAMERAS)	EA	27
902-99.05	TRAFFIC SIGNAL ADVANCED DETECTION SYSTEM (2 UNITS)	EA	19
902-99.06	TRAFFIC SIGNAL ADVANCED DETECTION SYSTEM (3 UNITS)	EA	9
902-99.07	TRAFFIC SIGNAL ADVANCED DETECTION SYSTEM (4 UNITS)	EA	10
902-99.10	CONDUIT REPAIR	LF	100
902-99.02	TRAFFIC SIGNAL VIDEO DETECTION SYSTEM (3 CAMERAS)	EA	11
902-99.02	TRAFFIC SIGNAL VIDEO DETECTION SYSTEM (4 CAMERAS)	EA	27
902-99.02	TRAFFIC SIGNAL ADVANCED DETECTION SYSTEM (2 UNITS)	EA	19
902-99.02	TRAFFIC SIGNAL ADVANCED DETECTION SYSTEM (3 UNITS)	EA	9
902-99.02	TRAFFIC SIGNAL ADVANCED DETECTION SYSTEM (4 UNITS)	EA	10
902-99.03	CONDUIT REPAIR	LF	100
902-99.09	3-INCH CONDUIT, RIGID, IN-TRENCH OR PUSHED	LF	100
910-52.01	CONDUIT, 3 IN., RIGID, IN TRENCH	LF	100
910-72.01	CONDUIT, 3 IN., RIGID, PUSHED	LF	100
910-88.11	PULL BOX, PREFORMED CLASS 2	EA	1
910-88.16	PULL BOX, PREFORMED CLASS 5	EA	1
910-99.01	AS-BUILT	LS	1
910-99.02	PULL ROPES	EA	38

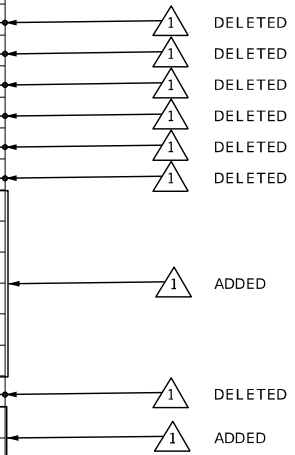

QUANTITY SHEET 1 OF 2

ST. LOUIS COUNTY
ROUTE 180 SIGNAL IMPROVEMENTS

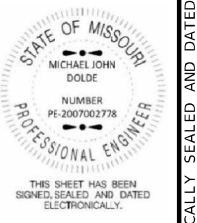

DATE PREPARED
08/23/2024
ROUTE 180 STATE MO
DISTRICT SL SHEET NO. 2
COUNTY ST. LOUIS
JOB NO. JSL0179
CONTRACT ID.

PROJECT NO.
BRIDGE NO.

DATE	DESCRIPTION
04/16/24	PRELIMINARY PLANS
06/21/24	FINAL PLANS
08/23/24	REVISION 1

MISSOURI HIGHWAYS AND TRANSPORTATION COMMISSION

105 WEST CAPITOL
JEFFERSON CITY, MO 65102
1-888-ASK-MODOT (1-888-275-6636)

WSP USA INC.
211 N. BROADWAY SUITE 2800
ST. LOUIS, MO 63102 (314) 206-4444
MISSOURI CERTIFICATE OF AUTHORITY - 001444

IF A SEAL IS PRESENT ON THIS SHEET IT HAS BEEN ELECTRONICALLY SEALED AND DATED. REV. 08/23/2024