

1 REVISED

1 REVISED

REMOVAL OF IMPROVEMENTS - LUMP SUM 1

DESIGNATION	DESCRIPTION
R1	1 - 45' X 35' BRICK/CONCRETE BLDG W/ FOUNDATION AND FOOTING
R2	2 - CONCRETE PICNIC SHELTER W/ 24' X 24' CONCRETE PAD
R3	4 - 12' X 12' PICNIC SHELTER WITH CONCRETE PAD (STEEL POSTS W/WOOD FRAMING AND SHINGLE ROOF)
R4	6 - 8' X 9' CONCRETE PAD FOR PICNIC TABLE
R5	17 - EXISTING LIGHT POLE AND FOUNDATION (COMMISSION RETAINED)
R6	1 - FLAG POLE AND FOUNDATION
R7	1 - LIGHTING CONTROLER CABINET
R8	4 - 18" PIPES (277 LF), 2 - DROP INLETS, 3 - 18" FLARED END SECTIONS
R9	EXISTING TRUCK PARKING PAVEMENT 6565 SY
R10	EXISTING PASSENGER CAR RAMP PAVEMENT 2447 SY
R11	EXISTING PASSENGER CAR PARKING AREAS PAVEMENT 1309 SY
R12	EXISTING SIDEWALK 990 SY
R14	1 - EXISTING PARKING GUIDE SIGN AT TRUCK PARKING AND CAR PARKING GORE, CUT STUBS FLUSH WITH THE FOOTING
R15	1 - EXISTING DO NOT ENTER SIGN, CUT STUBS FLUSH WITH THE FOOTING
	1 - EXISTING "REST AREA 45 DEGREE RIGHT ARROW" SIGN AT EXIT GORE (LM 99.200), CUT STUBS FLUSH WITH THE FOOTING
	1 - EXISTING "REST AREA 45 DEGREE RIGHT ARROW" SIGN AT DECEL LANE TAPER (LM 99.000), CUT STUBS FLUSH WITH THE FOOTING
	1 - "SOUTH I-55" ROUTE DESIGNATION SIGN (LM 98.700), CUT STUBS FLUSH WITH THE FOOTING
	1 - "REST AREA 3/4 MILE / NEXT REST AREA 69 MILES" SIGN (98.334), CUT STUBS FLUSH WITH THE FOOTING
	MISCELLANEOUS EXISTING REST AREA SIGNS AND FOOTING

MOBILIZATION  
LUMP SUM = 1

CONTRACTOR FURNISHED SURVEYING AND STAKING  
LUMP SUM = 1

WATER FIXTURE INSTALLATION  
LUMP SUM = 1

~~WASTEWATER LAGOON CLOSURE~~  
~~LUMP SUM = 1~~

1 DELETED

CLEARING AND GRUBBING  
1 ACRE

CONCRETE PAVEMENT

SHEET	STA	STA	LOCATION	LENGTH FT	WIDTH FT	6" TYPE 5 AGG BASE SY	9" CONC PAVEMENT SY	6" TYPE A INTEGRAL CURB LF	REMARK
5	0+00	10+18.07	BASELINE 1	1018.07	VAR.	7176.7	7176.7	801.3	
5	0+00	11+46.80	BASELINE 2	1147.00	VAR.	7467.00	7467.00	892.2	
TOTAL						14644	14644	1694	

CONCRETE SIDEWALK

SHEET	STA	STA	LOCATION	LENGTH FT	WIDTH FT	4" CONCRETE SIDEWALK SY	CONCRETE CURB RAMP SY	TRUNCATED DOMES SF	REMARKS
6	3+31.52	5+05.20	BASELINE 1	173.68	5	96.49			
6	5+05.20	5+30.20	BASELINE 1	25.00	5		13.89	10	
6	5+30.20	7+31.43	BASELINE 1	201.23	5	111.79			
6	4+53.00	5+85.53	BASELINE 2	132.53	5	73.63			
6	5+85.53	6+10.53	BASELINE 2	25.00	5		13.89	10	
6	6+10.53	8+70.78	BASELINE 2	260.25	5	144.58			
TOTAL						426.5	27.8	20	

EARTHWORK

STA	STA	LOC	L.G. CL 2 STA	ESTIMATED FILL CY	ESTIMATED CUT CY	COMPACTING IN CUT STA	REMARKS
0+00	10+18.07	LT BASELINE 1	10.2			10.2	
0+00	2+00	LT BASELINE 2	2.0	1333			
2+00	7+55.44	LT BASELINE 2	5.6		4208	5.6	
7+55.44	11+46.80	LT BASELINE 2	3.9	3137			
TOTAL				21.7		15.8	

CULVERT EXTENSION

SHEET	STA	LOC	15 IN. PIPE GROUP A LF	15 IN. GROUP A F.E.S. EA	REMARKS
10	1+16.84	BASELINE 2	24	1	
TOTAL			24	1	

EROSION CONTROL & SEEDING

SHEET	STATION	STATION	LOCATION	ROCK DITCH CHECK LF	ALTERNATE DITCH CHECK LF	SILT FENCE LF	SEDIMENT REMOVAL CY	SEEDING - COOL SEASON MIXTURE ACRE	MULCH ACRE	REMARKS
9	0+00	10+18.07	BASELINE 1		36	1186	15	1.01	1.01	
9	0+00	11+46.80	BASELINE 2	12	72	1603	23	2.54	2.54	
TOTAL				12	108	2789	38	3.6	3.6	

1 REVISED

STATE OF MISSOURI  
CURTIS DEWAYNE WOOLSEY  
PROFESSIONAL ENGINEER  
NUMBER PE-2001018834  
10/9/2024 4:02:14 PM  
CURTIS DEWAYNE WOOLSEY - CIVIL  
MO-PE-2001018834

DATE PREPARED  
10/9/2024

ROUTE STATE  
I-55 MO

DISTRICT SHEET NO.  
SE 3

COUNTY  
CAPE GIRARDEAU

JOB NO.  
JSEM0061

CONTRACT ID.

PROJECT NO.

BRIDGE NO.

DESCRIPTION

DATE


MISSOURI HIGHWAYS AND TRANSPORTATION COMMISSION

105 WEST CAPITOL  
JEFFERSON CITY, MO 65102  
1-888-ASK-MODOT (1-888-275-6636)

SUMMARY OF QUANTITIES  
SHEET 1 OF 3





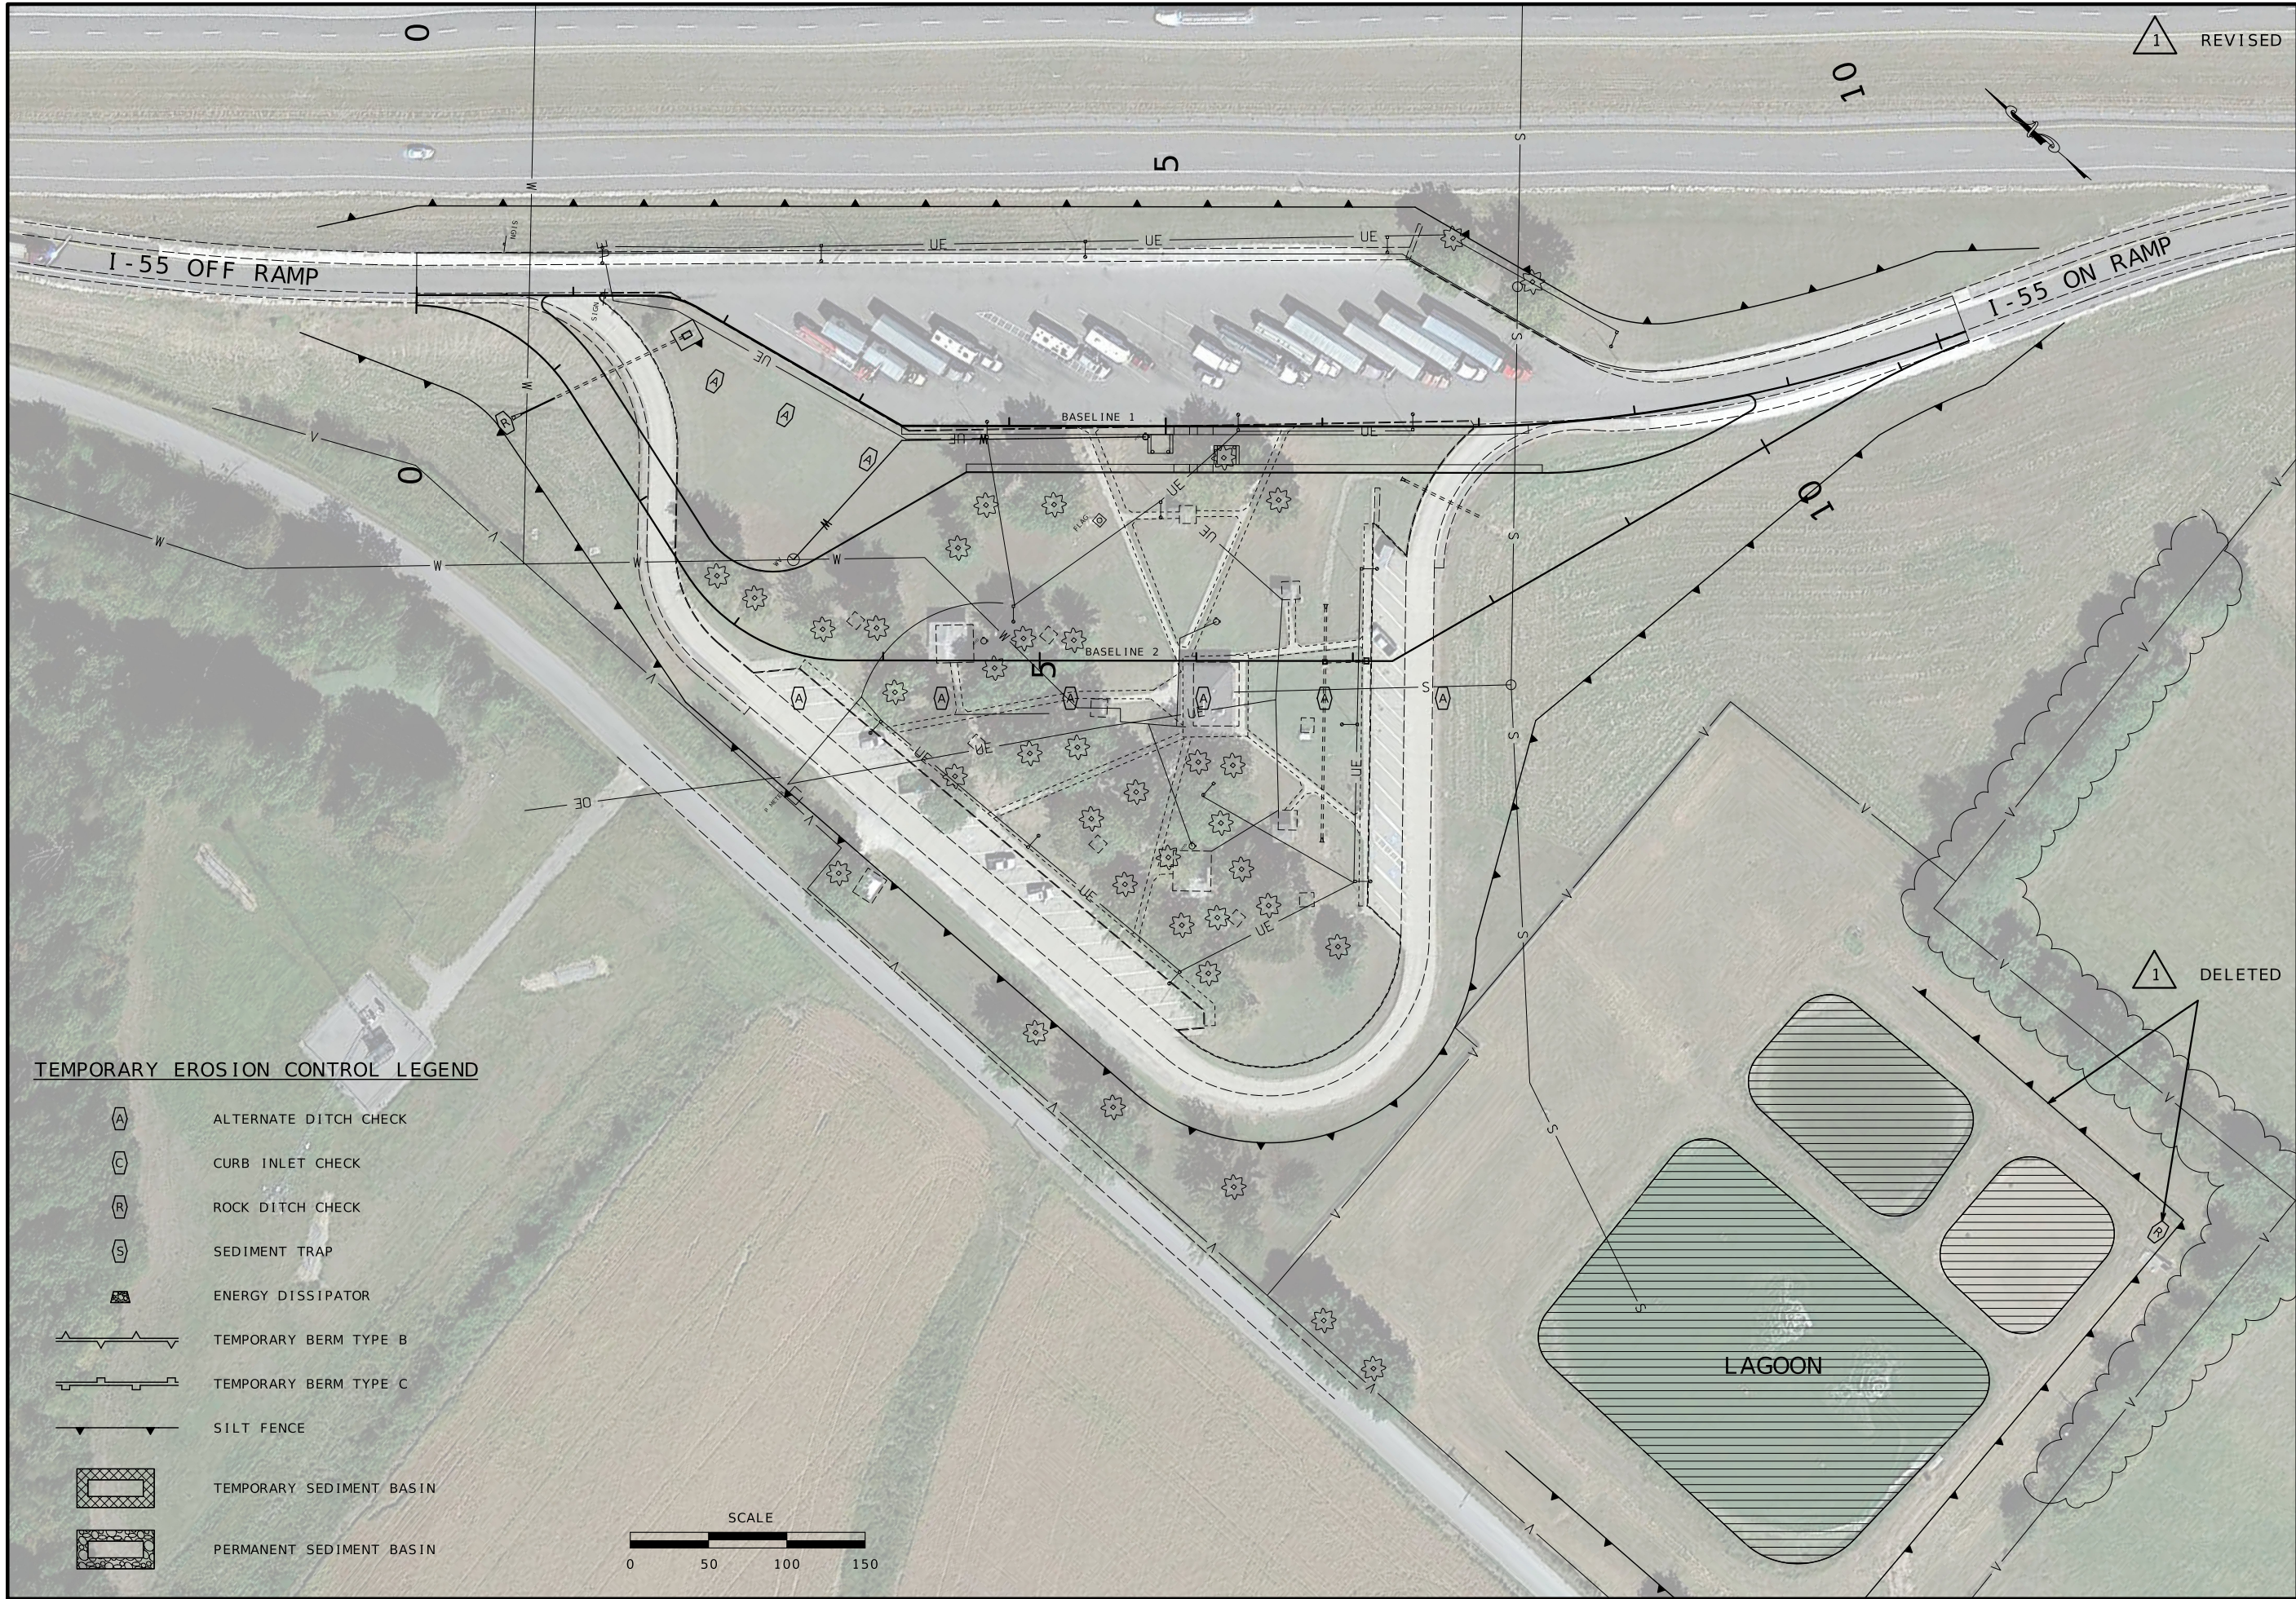

1 REVISED



Curtis Dewayne Woolsey  
 10/9/2024 4:02:21 PM  
 CURTIS DEWAYNE WOOLSEY - CIVIL  
 MO-PE-2001018834

DATE PREPARED  
 10/9/2024

ROUTE	STATE
I-55	MO
DISTRICT	SHEET NO.
SE	9

COUNTY  
 CAPE GIRARDEAU  
 JOB NO.  
 JSEM0061  
 CONTRACT ID.

PROJECT NO.  
 BRIDGE NO.

DATE	DESCRIPTION






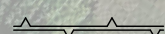
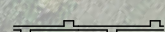
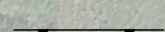

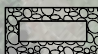
MISSOURI HIGHWAYS AND TRANSPORTATION  
 COMMISSION




105 WEST CAPITOL  
 JEFFERSON CITY, MO 65102  
 1-888-ASK-MODOT (1-888-275-6636)

1 DELETED

**TEMPORARY EROSION CONTROL LEGEND**

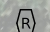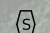-  ALTERNATE DITCH CHECK
-  CURB INLET CHECK
-  ROCK DITCH CHECK
-  SEDIMENT TRAP
-  ENERGY DISSIPATOR
-  TEMPORARY BERM TYPE B
-  TEMPORARY BERM TYPE C
-  SILT FENCE
-  TEMPORARY SEDIMENT BASIN
-  PERMANENT SEDIMENT BASIN

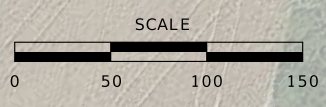

EROSION CONTROL SHEET  
 SHEET 1 OF 1

