

REMOVAL OF IMPROVEMENTS (TABLE 3 OF 5)				
STA.	STA.	RTE.	LOCATION	DESCRIPTION
MENDON CONTINUED				
13+32.91	14+41.29	ROUTE CC	42' LT.	61.3 SY CONCRETE SIDEWALK
14+63.48	15+25.00	ROUTE CC	42' LT.	47.5 SY CONCRETE SIDEWALK
15+25.00	17+05.49	ROUTE CC	44' LT.	134.6 SY CONCRETE SIDEWALK
17+37.03	18+00.00	ROUTE CC	44' LT.	53.6 SY CONCRETE SIDEWALK
18+00.00	20+75.00	ROUTE CC	44' LT.	208.4 SY CONCRETE SIDEWALK
20+75.00	21+68.81	ROUTE CC	44' LT.	78.3 SY CONCRETE SIDEWALK
21+53.89		ROUTE CC	34' LT.	15" X 8' CMP
25+62.94	26+14.27	ROUTE CC	36' LT.	30.0 SY CONCRETE SIDEWALK
27+88.15	28+77.17	ROUTE CC	35' LT.	28.9 SY CONCRETE SIDEWALK
29+21.75	30+28.83	ROUTE CC	37' LT.	37.3 SY CONCRETE SIDEWALK
30+69.65	31+50.00	ROUTE CC	39' LT.	28.5 SY CONCRETE SIDEWALK
31+50.00	31+73.11	ROUTE CC	40' LT.	7.2 SY CONCRETE SIDEWALK
32+12.89	32+49.11	ROUTE CC	31' LT.	7.1 SY CONCRETE SIDEWALK
KEYTESVILLE				
9+56.84	10+73.71	ROUTE K	42' LT.	45.0 SY CONCRETE SIDEWALK
NORBORNE				
1206+35.88		ROUTE D	22' LT.	STREET SIGN
1204+96.80	1208+86.78	ROUTE D	28' LT.	33.1 SY CONCRETE SIDEWALK
1206+21.40	1206+68.37	ROUTE D	25' LT.	19.9 SY CONCRETE SIDEWALK
1206+93.70	1207+29.08	ROUTE D	26' LT.	17.8 SY CONCRETE SIDEWALK
1207+61.87	1208+24.07	ROUTE D	27' LT.	22.3 SY CONCRETE SIDEWALK
1208+36.23	1208+50.00	ROUTE D	27' LT.	6.0 SY CONCRETE SIDEWALK
1208+50.00	1210+46.82	ROUTE D	28' LT.	73.5 SY CONCRETE SIDEWALK
1210+67.14	1211+00.00	ROUTE D	28' LT.	12.5 SY CONCRETE SIDEWALK
1211+00.00	1211+97.92	ROUTE D	28' LT.	29.1 SY CONCRETE SIDEWALK
1212+30.67	1212+78.12	ROUTE D	28' LT.	13.2 SY CONCRETE SIDEWALK
1217+83.33	1218+50.00	ROUTE D	26' LT.	65.8 SY CONCRETE SIDEWALK
1218+36.73		ROUTE D	30' LT.	ASPHALT RAMP
1218+50.00	1218+91.38	ROUTE D	26' LT.	36.6 SY CONCRETE SIDEWALK
1219+54.00	1221+25.00	ROUTE D	23' LT.	103.2 SY CONCRETE SIDEWALK
1221+25.00	1221+43.84	ROUTE D	26' LT.	14.1 SY CONCRETE SIDEWALK
1223+69.17	1223+82.21	ROUTE D	26' LT.	5.0 SY CONCRETE SIDEWALK
1224+28.55	1225+34.38	ROUTE D	26' LT.	51.6 SY CONCRETE SIDEWALK
1225+65.34	1226+04.27	ROUTE D	27' LT.	18.6 SY CONCRETE SIDEWALK
1226+32.15	1227+42.35	ROUTE D	26' LT.	55.2 SY CONCRETE SIDEWALK
1227+30.34		ROUTE D	24' LT.	STREET SIGN
1227+86.89	1228+75.00	ROUTE D	26' LT.	27.7 SY CONCRETE SIDEWALK
1228+75.00	1231+25.00	ROUTE D	26' LT.	92.2 SY CONCRETE SIDEWALK
1231+25.00	1232+68.10	ROUTE D	27' LT.	51.1 SY CONCRETE SIDEWALK
1232+87.23	1233+75.00	ROUTE D	27' LT.	26.5 SY CONCRETE SIDEWALK
1233+75.00	1234+69.07	ROUTE D	27' LT.	28.7 SY CONCRETE SIDEWALK
1234+93.72	1236+17.11	ROUTE D	28' LT.	49.1 SY CONCRETE SIDEWALK
1236+10.26		ROUTE D	26' LT.	REMOVE POST/SIGN
PAID BY LUMP SUM CONTINUED				
SEE REMOVAL OF IMPROVEMENTS TABLE 5 OF 5 FOR PAY QUANTITY				

REMOVAL OF IMPROVEMENTS (TABLE 4 OF 5)				
STA.	STA.	RTE.	LOCATION	DESCRIPTION
NORBORNE CONTINUED				
1236+44.56	1238+75.00	ROUTE D	28' LT.	84.3 SY CONCRETE SIDEWALK
1238+75.00	1239+87.73	ROUTE D	29' LT.	32.5 SY CONCRETE SIDEWALK
1209+47.84	1211+00.00	ROUTE D	26' RT.	837 SY CONCRETE SIDEWALK
1211+00.00	1212+72.91	ROUTE D	25' RT.	91.5 SY CONCRETE SIDEWALK
1213+32.96	1213+50.00	ROUTE D	25' RT.	6.5 SY CONCRETE SIDEWALK
1213+50.00	1214+26.40	ROUTE D	25' RT.	30.6 SY CONCRETE SIDEWALK
1217+83.98		ROUTE D	29' RT.	STOP SIGN WITH SPEED LIMIT SIGN ATTACHED
1217+84.17	1218+50.00	ROUTE D	25' RT.	59.1 SY CONCRETE SIDEWALK
1218+50.00	1218+95.27	ROUTE D	25' RT.	35.0 SY CONCRETE SIDEWALK
1219+15.82	1220+13.24	ROUTE D	25' RT.	106.1 SY CONCRETE SIDEWALK
1219+21.35		ROUTE D	21' RT.	4" X 57' CMP
1220+08.26		ROUTE D	26' RT.	STREET SIGN
1220+12.65		ROUTE D	32' RT.	4" X 14' CMP
1221+25.00	1221+89.68	ROUTE D	25' RT.	32.8 SY CONCRETE SIDEWALK
1223+64.85	1223+81.59	ROUTE D	28' RT.	8.2 SY CONCRETE SIDEWALK
1224+19.98	1226+27.38	ROUTE D	28' RT.	89.2 SY CONCRETE SIDEWALK
1226+48.10	1226+82.20	ROUTE D	28' RT.	19.5 SY CONCRETE SIDEWALK
1227+12.83	1227+38.74	ROUTE D	28' RT.	16.9 SY CONCRETE SIDEWALK
1227+77.46	1228+75.00	ROUTE D	28' RT.	42.7 SY CONCRETE SIDEWALK
1228+75.00	1230+55.97	ROUTE D	27' RT.	60.6 SY CONCRETE SIDEWALK
1230+85.95	1231+25.00	ROUTE D	29' RT.	11.7 SY CONCRETE SIDEWALK
1231+25.00	1232+65.79	ROUTE D	29' RT.	43.4 SY CONCRETE SIDEWALK
1232+93.21	1233+75.00	ROUTE D	29' RT.	25.5 SY CONCRETE SIDEWALK
1233+75.00	1236+18.85	ROUTE D	29' RT.	85.6 SY CONCRETE SIDEWALK
1236+42.96	1237+65.17	ROUTE D	27' RT.	39.1 SY CONCRETE SIDEWALK
1237+76.95	1238+53.99	ROUTE D	27' RT.	19.6 SY CONCRETE SIDEWALK
1238+53.99	1238+75.00	ROUTE D	27' RT.	5.9 SY CONCRETE SIDEWALK
1238+75.00	1241+25.00	ROUTE D	27' RT.	78.3 SY CONCRETE SIDEWALK
1241+25.00	1241+85.23	ROUTE D	27' RT.	20.0 SY CONCRETE SIDEWALK
BOSWORTH				
438+36.76	439+76.86	ROUTE M	18' LT.	45.8 SY CONCRETE SIDEWALK
443+20.93	443+87.75	ROUTE M	39' LT.	45.6 SY CONCRETE SIDEWALK
444+00.70	445+00.00	ROUTE M	38' LT.	55.0 SY CONCRETE SIDEWALK
445+00.00	446+21.68	ROUTE M	36' LT.	67.2 SY CONCRETE SIDEWALK
447+19.73	447+50.00	ROUTE M	36' LT.	14.7 SY CONCRETE SIDEWALK
447+50.00	450+00.00	ROUTE M	35' LT.	217.1 SY CONCRETE SIDEWALK
450+00.00	451+05.10	ROUTE M	37' LT.	106.3 SY CONCRETE SIDEWALK
450+82.05		ROUTE M	29' LT.	REMOVE POST
597+01.20	597+29.70	ROUTE 139	31' LT.	43' FENCE
597+02.65	597+45.70	ROUTE 139	36' LT.	17.0 SY CONCRETE SIDEWALK
597+67.30	598+63.41	ROUTE 139	35' LT.	29.1 SY CONCRETE SIDEWALK
600+82.22	599+56.44	ROUTE 139	36' LT.	39.9 SY CONCRETE SIDEWALK
604+56.01	605+28.42	ROUTE 139	35' LT.	6.3 SY CONCRETE SIDEWALK
PAID BY LUMP SUM CONTINUED				
SEE REMOVAL OF IMPROVEMENTS TABLE 5 OF 5 FOR PAY QUANTITY				

DATE PREPARED
5/5/2025

ROUTE
VARIOUS

DISTRICT
NW

STATE
MO

SHEET NO.
3

COUNTY
CHARITON / CARROLL

JOB NO.
JNW0030

CONTRACT ID.

PROJECT NO.

BRIDGE NO.

DESCRIPTION
SIDEWALK
REROUTE

DATE
5/5/25

MISSOURI HIGHWAYS AND TRANSPORTATION
COMMISSION



105 WEST CAPITOL
JEFFERSON CITY, MO 65102
1-888-ASK-MODOT (1-888-275-6636)

2215 Fairlawn Dr
Carthage, MO 64836
417.358.9551
COA# 00062
weareown.com




Engineering beyond.

1

SHEET DELETED

SUMMARY OF QUANTITIES
SHEET 2 OF 20

IF A SEAL IS PRESENT ON THIS SHEET IT HAS BEEN ELECTRONICALLY SEALED AND DATED.

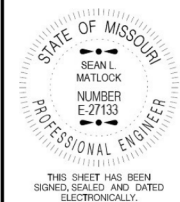

DATE PREPARED
5/5/2025

ROUTE STATE
VARIOUS MO
DISTRICT SHEET NO.
NW 3A

COUNTY
CHARLTON / CARROLL

JOB NO.
JNW0030

CONTRACT ID.

PROJECT NO.

BRIDGE NO.

DATE	DESCRIPTION			
	SIDEWALK	REROUTE		
5/5/25				

MISSOURI HIGHWAYS AND TRANSPORTATION COMMISSION



105 WEST CAPITOL
JEFFERSON CITY, MO 65102
1-888-ASK-MODOT (1-888-275-6636)

2215 Fairlawn Dr
Carthage, MO 64836
417.358.9551
COA# 00062
weareown.com



Engineering beyond.

IF A SEAL IS PRESENT ON THIS SHEET IT HAS BEEN ELECTRONICALLY SEALED AND DATED.

REMOVAL OF IMPROVEMENTS (TABLE 3 OF 5)

STA.	STA.	RTE.	LOCATION	DESCRIPTION
MENDON CONTINUED				
13+32.91	14+41.29	ROUTE CC	42' LT.	61.3 SY CONCRETE SIDEWALK
14+63.48	15+25.00	ROUTE CC	42' LT.	47.5 SY CONCRETE SIDEWALK
15+25.00	17+05.49	ROUTE CC	44' LT.	134.6 SY CONCRETE SIDEWALK
17+37.03	18+00.00	ROUTE CC	44' LT.	53.6 SY CONCRETE SIDEWALK
18+00.00	20+75.00	ROUTE CC	44' LT.	208.4 SY CONCRETE SIDEWALK
20+75.00	21+68.81	ROUTE CC	44' LT.	78.3 SY CONCRETE SIDEWALK
21+53.89		ROUTE CC	34' LT.	15" X 8' CMP
27+88.15	28+77.17	ROUTE CC	35' LT.	28.9 SY CONCRETE SIDEWALK
29+21.75	30+28.83	ROUTE CC	37' LT.	37.3 SY CONCRETE SIDEWALK
30+69.65	31+50.00	ROUTE CC	39' LT.	28.5 SY CONCRETE SIDEWALK
31+50.00	31+73.11	ROUTE CC	40' LT.	7.2 SY CONCRETE SIDEWALK
32+12.89	32+49.11	ROUTE CC	31' LT.	7.1 SY CONCRETE SIDEWALK
KEYTESVILLE				
9+56.84	10+73.71	ROUTE K	42' LT.	45.0 SY CONCRETE SIDEWALK
NORBORNE				
1206+35.88		ROUTE D	22' LT.	STREET SIGN
1204+96.80	1208+86.78	ROUTE D	28' LT.	33.1 SY CONCRETE SIDEWALK
1206+21.40	1206+68.37	ROUTE D	25' LT.	19.9 SY CONCRETE SIDEWALK
1206+93.70	1207+29.08	ROUTE D	26' LT.	17.8 SY CONCRETE SIDEWALK
1207+61.87	1208+24.07	ROUTE D	27' LT.	22.3 SY CONCRETE SIDEWALK
1208+36.23	1208+50.00	ROUTE D	27' LT.	6.0 SY CONCRETE SIDEWALK
1208+50.00	1210+46.82	ROUTE D	28' LT.	73.5 SY CONCRETE SIDEWALK
1210+67.14	1211+00.00	ROUTE D	28' LT.	12.5 SY CONCRETE SIDEWALK
1211+00.00	1211+97.92	ROUTE D	28' LT.	29.1 SY CONCRETE SIDEWALK
1212+30.67	1212+78.12	ROUTE D	28' LT.	13.2 SY CONCRETE SIDEWALK
1217+83.33	1218+50.00	ROUTE D	26' LT.	65.8 SY CONCRETE SIDEWALK
1218+36.73		ROUTE D	30' LT.	ASPHALT RAMP
1218+50.00	1218+91.38	ROUTE D	26' LT.	36.6 SY CONCRETE SIDEWALK
1219+54.00	1221+25.00	ROUTE D	23' LT.	103.2 SY CONCRETE SIDEWALK
1221+25.00	1221+43.84	ROUTE D	26' LT.	14.1 SY CONCRETE SIDEWALK
1223+69.17	1223+82.21	ROUTE D	26' LT.	5.0 SY CONCRETE SIDEWALK
1224+28.55	1225+34.38	ROUTE D	26' LT.	51.6 SY CONCRETE SIDEWALK
1225+65.34	1226+04.27	ROUTE D	27' LT.	18.6 SY CONCRETE SIDEWALK
1226+32.15	1227+42.35	ROUTE D	26' LT.	55.2 SY CONCRETE SIDEWALK
1227+30.34		ROUTE D	24' LT.	STREET SIGN
1227+86.89	1228+75.00	ROUTE D	26' LT.	27.7 SY CONCRETE SIDEWALK
1228+75.00	1231+25.00	ROUTE D	26' LT.	92.2 SY CONCRETE SIDEWALK
1231+25.00	1232+68.10	ROUTE D	27' LT.	51.1 SY CONCRETE SIDEWALK
1232+87.23	1233+75.00	ROUTE D	27' LT.	26.5 SY CONCRETE SIDEWALK
1233+75.00	1234+69.07	ROUTE D	27' LT.	28.7 SY CONCRETE SIDEWALK
1234+93.72	1236+17.11	ROUTE D	28' LT.	49.1 SY CONCRETE SIDEWALK
1236+10.26		ROUTE D	26' LT.	REMOVE POST/SIGN
PAID BY LUMP SUM CONTINUED				
SEE REMOVAL OF IMPROVEMENTS TABLE 5 OF 5 FOR PAY QUANTITY				

REMOVAL OF IMPROVEMENTS (TABLE 4 OF 5)

STA.	STA.	RTE.	LOCATION	DESCRIPTION
NORBORNE CONTINUED				
1236+44.56	1238+75.00	ROUTE D	28' LT.	84.3 SY CONCRETE SIDEWALK
1238+75.00	1239+87.73	ROUTE D	29' LT.	32.5 SY CONCRETE SIDEWALK
1209+47.84	1211+00.00	ROUTE D	26' RT.	837 SY CONCRETE SIDEWALK
1211+00.00	1212+72.91	ROUTE D	25' RT.	91.5 SY CONCRETE SIDEWALK
1213+32.96	1213+50.00	ROUTE D	25' RT.	6.5 SY CONCRETE SIDEWALK
1213+50.00	1214+26.40	ROUTE D	25' RT.	30.6 SY CONCRETE SIDEWALK
1217+83.98		ROUTE D	29' RT.	STOP SIGN WITH SPEED LIMIT SIGN ATTACHED
1217+84.17	1218+50.00	ROUTE D	25' RT.	59.1 SY CONCRETE SIDEWALK
1218+50.00	1218+95.27	ROUTE D	25' RT.	35.0 SY CONCRETE SIDEWALK
1219+15.82	1220+13.24	ROUTE D	25' RT.	106.1 SY CONCRETE SIDEWALK
1219+21.35		ROUTE D	21' RT.	4" X 57' CMP
1220+08.26		ROUTE D	26' RT.	STREET SIGN
1220+12.65		ROUTE D	32' RT.	4" X 14' CMP
1221+25.00	1221+89.68	ROUTE D	25' RT.	32.8 SY CONCRETE SIDEWALK
1223+64.85	1223+81.59	ROUTE D	28' RT.	8.2 SY CONCRETE SIDEWALK
1224+19.98	1226+27.38	ROUTE D	28' RT.	89.2 SY CONCRETE SIDEWALK
1226+48.10	1226+82.20	ROUTE D	28' RT.	19.5 SY CONCRETE SIDEWALK
1227+12.83	1227+38.74	ROUTE D	28' RT.	16.9 SY CONCRETE SIDEWALK
1227+77.46	1228+75.00	ROUTE D	28' RT.	42.7 SY CONCRETE SIDEWALK
1228+75.00	1230+55.97	ROUTE D	27' RT.	60.6 SY CONCRETE SIDEWALK
1230+85.95	1231+25.00	ROUTE D	29' RT.	11.7 SY CONCRETE SIDEWALK
1231+25.00	1232+65.79	ROUTE D	29' RT.	43.4 SY CONCRETE SIDEWALK
1232+93.21	1233+75.00	ROUTE D	29' RT.	25.5 SY CONCRETE SIDEWALK
1233+75.00	1236+18.85	ROUTE D	29' RT.	85.6 SY CONCRETE SIDEWALK
1236+42.96	1237+65.17	ROUTE D	27' RT.	39.1 SY CONCRETE SIDEWALK
1237+76.95	1238+53.99	ROUTE D	27' RT.	19.6 SY CONCRETE SIDEWALK
1238+53.99	1238+75.00	ROUTE D	27' RT.	5.9 SY CONCRETE SIDEWALK
1238+75.00	1241+25.00	ROUTE D	27' RT.	78.3 SY CONCRETE SIDEWALK
1241+25.00	1241+85.23	ROUTE D	27' RT.	20.0 SY CONCRETE SIDEWALK
BOSWORTH				
438+36.76	439+76.86	ROUTE M	18' LT.	45.8 SY CONCRETE SIDEWALK
443+20.93	443+87.75	ROUTE M	39' LT.	45.6 SY CONCRETE SIDEWALK
444+00.70	445+00.00	ROUTE M	38' LT.	55.0 SY CONCRETE SIDEWALK
445+00.00	446+21.68	ROUTE M	36' LT.	67.2 SY CONCRETE SIDEWALK
447+19.73	447+50.00	ROUTE M	36' LT.	14.7 SY CONCRETE SIDEWALK
447+50.00	450+00.00	ROUTE M	35' LT.	217.1 SY CONCRETE SIDEWALK
450+00.00	451+05.10	ROUTE M	37' LT.	106.3 SY CONCRETE SIDEWALK
450+82.05		ROUTE M	29' LT.	REMOVE POST
597+01.20	597+29.70	ROUTE 139	31' LT.	43' FENCE
597+02.65	597+45.70	ROUTE 139	36' LT.	17.0 SY CONCRETE SIDEWALK
597+67.30	598+63.41	ROUTE 139	35' LT.	29.1 SY CONCRETE SIDEWALK
600+82.22	599+56.44	ROUTE 139	36' LT.	39.9 SY CONCRETE SIDEWALK
604+56.01	605+28.42	ROUTE 139	35' LT.	6.3 SY CONCRETE SIDEWALK
PAID BY LUMP SUM CONTINUED				
SEE REMOVAL OF IMPROVEMENTS TABLE 5 OF 5 FOR PAY QUANTITY				

CONCRETE SIDEWALKS (TABLE 3 OF 9)									
STA.	STA.	ROUTE	LOCATION	4" SIDEWALK (SY)	CURB RAMP (SY)	4" TYPE 1 AGGR. (SY)	ADA LINEAR GRADING (LF)	TRUNCATED DOME (SF)	REMARKS
ROTHVILLE (CONTINUED)									
59+97.68	61+19.47	ROUTE E	RT.	68.0		68.0	122.4		
61+27.85	61+83.96	ROUTE E	RT.	31.0		31.0	55.9		
61+94.44	63+03.46	ROUTE E	RT.	60.7		60.7	109.2		
63+74.61	64+02.76	ROUTE E	RT.	13.5		13.5	28.2		
64+02.76	65+58.09	ROUTE E	RT.	145.5		145.5	155.3	10.0	INCLUDES SIDEWALK TO EXIST. EOP
67+04.85	67+73.38	ROUTE E	RT.	38.4		38.4	68.0		
67+84.70	68+90.18	ROUTE E	RT.	60.6		60.6	105.5		
68+46.52	68+51.52	ROUTE E	RT.		5.6	5.6	10.0	10.0	
69+07.06	70+25.86	ROUTE E	RT.	66.3		66.3	119.0		INCLUDES SIDEWALK TO EXIST. SIDEWALK AT RESIDENCE
70+45.86	71+53.48	ROUTE E	RT.	60.0		60.0	107.5		
71+71.68	72+57.98	ROUTE E	RT.	48.2		48.2	86.2		INCLUDES SIDEWALK TO EXIST. SIDEWALK AT RESIDENCE
72+67.22	74+13.68	ROUTE E	RT.	81.3		81.3	146.5		
MENDON									
12+86.55	12+91.55	ROUTE CC	LT.		5.6	5.6	10.1	10.0	
12+86.55	13+75.41	ROUTE CC	LT.	54.2		54.2	97.6		INCLUDES SIDEWALK PERPENDICULAR TO EOS
13+86.98	14+13.39	ROUTE CC	LT.	14.6		14.6	26.3		
14+32.16	15+66.13	ROUTE CC	LT.	97.4		97.4	134.4	10.0	
15+84.96	16+95.86	ROUTE CC	LT.	62.9		62.9	113.3		
16+95.86	17+05.86	ROUTE CC	LT.		5.6	5.6	10.0		
16+89.63	16+94.63	ROUTE CC	LT.		5.6	5.6	10.0		
16+89.56	16+94.56	ROUTE CC	LT.					10.0	
17+34.95	17+45.57	ROUTE CC	LT.		5.8	5.8	10.4		
17+35.57	17+37.57	ROUTE CC	LT.					10.0	
17+48.13	17+53.13	ROUTE CC	LT.		5.7	5.7	11.0		
17+48.06	17+53.06	ROUTE CC	LT.					10.0	
17+45.57	18+50.19	ROUTE CC	LT.	63.5		63.5	107.9	10.0	INCLUDES SIDEWALK PERP. TO ROAD AND TO EXIST. SIDEWALK AT RESIDENCE
18+50.19	18+72.57	ROUTE CC	LT.	24.3		24.3	22.4	10.0	SIDEWALK (7' WIDE)
18+10.76	18+15.76	ROUTE CC	LT.		4.8	4.8	5.0		FROM SIDEWALK TO EOS ROUTE CC
18+72.57	18+76.44	ROUTE CC	LT.	3.0		3.0	3.9		SIDEWALK (7' WIDE)
18+76.44	18+98.65	ROUTE CC	LT.	17.3		17.3	22.2		SIDEWALK (7' WIDE)
18+98.65	20+42.18	ROUTE CC	LT.	87.3		87.3	142.9		
20+04.68	20+09.68	ROUTE CC	LT.		6.2	6.2	11.2		FROM SIDEWALK TO EOS ROUTE CC
20+51.28	21+19.58	ROUTE CC	LT.	57.3		57.3	68.0		
21+35.58	21+48.66	ROUTE CC	LT.	14.6		14.6	19.4		
21+43.66	21+48.66	ROUTE CC	LT.		5.6	5.6	10.0	10.0	FROM SIDEWALK TO EOS ROUTE CC
25+68.57	25+72.19	ROUTE CC	LT.		5.7	5.7	10.0		
25+65.95	25+69.77	ROUTE CC	LT.					10.0	
25+74.34	27+08.79	ROUTE CC	LT.	92.6		92.6	171.6		
27+18.13	28+66.27	ROUTE CC	LT.	82.3		82.3	148.1		
28+66.27	28+79.84	ROUTE CC	LT.		7.4	7.4	13.6		
28+77.27	28+79.27	ROUTE CC	LT.					10.0	
28+93.05	29+06.69	ROUTE CC	LT.		7.1	7.1	12.8		
28+94.69	28+96.69	ROUTE CC	LT.					10.0	
29+06.69	30+44.10	ROUTE CC	LT.	71.9		71.9	139.4		
SUBTOTALS				1416.7	70.6	1487.3	2445.2	130.0	

1

SHEET DELETED

SUMMARY OF QUANTITIES
SHEET 6 OF 20

DATE	DESCRIPTION
5/5/25	SIDEWALK REROUTE

MISSOURI HIGHWAYS AND TRANSPORTATION COMMISSION



105 WEST CAPITOL
JEFFERSON CITY, MO 65102
1-888-ASK-MODOT (1-888-275-6636)

2215 Fairlawn Dr
Carthage, MO 64836
417.358.9551
COA# 00062
weareown.com



Engineering beyond.

IF A SEAL IS PRESENT ON THIS SHEET IT HAS BEEN ELECTRONICALLY SEALED AND DATED.

CONCRETE SIDEWALKS (TABLE 3 OF 9)									
STA.	STA.	ROUTE	LOCATION	4" SIDEWALK (SY)	CURB RAMP (SY)	4" TYPE 1 AGGR. (SY)	ADA LINEAR GRADING (LF)	TRUNCATED DOME (SF)	REMARKS
ROTHVILLE (CONTINUED)									
59+97.68	61+19.47	ROUTE E	RT.	68.0		68.0	122.4		
61+27.85	61+83.96	ROUTE E	RT.	31.0		31.0	55.9		
61+94.44	63+03.46	ROUTE E	RT.	60.7		60.7	109.2		
63+74.61	64+02.76	ROUTE E	RT.	13.5		13.5	28.2		
64+02.76	65+58.09	ROUTE E	RT.	145.5		145.5	155.3	10.0	INCLUDES SIDEWALK TO EXIST. EOP
67+04.85	67+73.38	ROUTE E	RT.	38.4		38.4	68.0		
67+84.70	68+90.18	ROUTE E	RT.	60.6		60.6	105.5		
68+46.52	68+51.52	ROUTE E	RT.		5.6	5.6	10.0	10.0	
69+07.06	70+25.86	ROUTE E	RT.	66.3		66.3	119.0		INCLUDES SIDEWALK TO EXIST. SIDEWALK AT RESIDENCE
70+45.86	71+53.48	ROUTE E	RT.	60.0		60.0	107.5		
71+71.68	72+57.98	ROUTE E	RT.	48.2		48.2	86.2		INCLUDES SIDEWALK TO EXIST. SIDEWALK AT RESIDENCE
72+67.22	74+13.68	ROUTE E	RT.	81.3		81.3	146.5		
MENDON									
12+86.55	12+91.55	ROUTE CC	LT.		5.6	5.6	10.1	10.0	
12+86.55	13+75.41	ROUTE CC	LT.	54.2		54.2	97.6		INCLUDES SIDEWALK PERPENDICULAR TO EOS
13+86.98	14+13.39	ROUTE CC	LT.	14.6		14.6	26.3		
14+32.16	15+66.13	ROUTE CC	LT.	97.4		97.4	134.4	10.0	
15+84.96	16+95.86	ROUTE CC	LT.	62.9		62.9	113.3		
16+95.86	17+05.86	ROUTE CC	LT.		5.6	5.6	10.0		
16+89.63	16+94.63	ROUTE CC	LT.		5.6	5.6	10.0		
16+89.56	16+94.56	ROUTE CC	LT.					10.0	
17+34.95	17+45.57	ROUTE CC	LT.		5.8	5.8	10.4		
17+35.57	17+37.57	ROUTE CC	LT.					10.0	
17+48.13	17+53.13	ROUTE CC	LT.		5.7	5.7	11.0		
17+48.06	17+53.06	ROUTE CC	LT.					10.0	
17+45.57	18+50.19	ROUTE CC	LT.	63.5		63.5	107.9	10.0	INCLUDES SIDEWALK PERP. TO ROAD AND TO EXIST. SIDEWALK AT RESIDENCE
18+50.19	18+72.57	ROUTE CC	LT.	24.3		24.3	22.4	10.0	SIDEWALK (7' WIDE)
18+10.76	18+15.76	ROUTE CC	LT.		4.8	4.8	5.0		FROMSIDEWALK TO EOS ROUTE CC
18+72.57	18+76.44	ROUTE CC	LT.	3.0		3.0	3.9		SIDEWALK (7' WIDE)
18+76.44	18+98.65	ROUTE CC	LT.	17.3		17.3	22.2		SIDEWALK (7' WIDE)
18+98.65	20+42.18	ROUTE CC	LT.	87.3		87.3	142.9		
20+04.68	20+09.68	ROUTE CC	LT.		6.2	6.2	11.2		FROMSIDEWALK TO EOS ROUTE CC
20+51.28	21+19.58	ROUTE CC	LT.	57.3		57.3	68.0		
21+35.58	21+48.66	ROUTE CC	LT.	14.6		14.6	19.4		
21+43.66	21+48.66	ROUTE CC	LT.		5.6	5.6	10.0	10.0	FROMSIDEWALK TO EOS ROUTE CC
25+68.57	25+72.19	ROUTE CC	LT.		5.7	5.7	10.0		
29+80.31	30+44.10	ROUTE CC	LT.	31.0	16.0	71.9	139.4	10.0	
30+60.10	31+87.96	ROUTE CC	LT.	69.9		69.9	127.1		
32+12.38	32+35.43	ROUTE CC	LT.	8.3		8.3	23.1		FROMSIDEWALK TO EOS ROUTE CC
32+35.43	32+50.25	ROUTE CC	LT.		6.9	6.9	14.8		
32+44.21	32+46.10	ROUTE CC	LT.					10.0	
8+78.93	8+82.95	ROUTE CC	RT.	2.6		2.6	4.6		
8+82.95	9+01.63	ROUTE CC	RT.		11.8	11.8	21.3		
8+99.76	9+01.53	ROUTE CC	RT.					10.0	
			SUBTOTALS	1281.7	90.8	1397.4	2290.0	130.0	

1

SHEET ADDED

SUMMARY OF QUANTITIES
SHEET 6 OF 20

STATE OF MISSOURI

SEAN L. MATLOCK

NUMBER E-27133

PROFESSIONAL ENGINEER

THIS SHEET HAS BEEN SIGNED, SEALED AND DATED ELECTRONICALLY.

DATE PREPARED
5/5/2025

ROUTE
VARIOUS

STATE
MO

DISTRICT
NW

SHEET NO.
3A

COUNTY
CHARITON / CARROLL

JOB NO.
JNW0030

CONTRACT ID.

PROJECT NO.

BRIDGE NO.

DESCRIPTION

DATE

5/5/25

SIDEWALK

REROUTE

MISSOURI HIGHWAYS AND TRANSPORTATION COMMISSION

MoDOT

105 WEST CAPITOL
JEFFERSON CITY, MO 65102
1-888-ASK-MODOT (1-888-275-6636)

2215 Fairlawn Dr
Carthage, MO 64836
417.358.9551
COA# 00062
weareown.com

OWN

Engineering beyond.™

IF A SEAL IS PRESENT ON THIS SHEET IT HAS BEEN ELECTRONICALLY SEALED AND DATED.

CONCRETE SIDEWALKS (TABLE 4 OF 9)									
STA.	STA.	ROUTE	LOCATION	4" SIDEWALK (SY)	CURB RAMP (SY)	4" TYPE 1 AGGR. (SY)	ADA LINEAR GRADING (LF)	TRUNCATED DOME (SF)	REMARKS
MENDON (CONTINUED)									
30+60.10	31+87.96	ROUTE CC	LT.	69.9		69.9	127.1		
32+12.38	32+35.43	ROUTE CC	LT.	8.3		8.3	23.1		FROM SIDEWALK TO EOS ROUTE CC
32+35.43	32+50.25	ROUTE CC	LT.		6.9	6.9	14.8		
32+44.21	32+46.10	ROUTE CC	LT.					10.0	
8+78.93	8+82.95	ROUTE CC	RT.	2.6		2.6	4.6		
8+82.95	9+01.63	ROUTE CC	RT.		11.8	11.8	21.3		
8+99.76	9+01.53	ROUTE CC	RT.					10.0	
9+21.48	9+31.41	ROUTE CC	RT.	5.8		5.8	10.6		
9+22.44	9+24.24	ROUTE CC	RT.					10.0	
9+31.41	10+57.74	ROUTE CC	RT.	73.5		73.5	131.5		
10+57.74	10+69.29	ROUTE CC	RT.	6.1		6.11	11.1		
10+65.74	10+67.74	ROUTE CC	RT.					10.0	
10+91.46	11+05.13	ROUTE CC	RT.	6.6		6.6	11.8		
10+95.14	10+97.14	ROUTE CC	RT.					10.0	
11+05.13	12+38.06	ROUTE CC	RT.	74.0		74.0	132.9		
12+38.06	12+48.06	ROUTE CC	RT.		5.6	5.6	10.1		
12+46.06	12+48.06	ROUTE CC	RT.					10.0	
12+72.71	12+83.09	ROUTE CC	RT.		5.7	5.7	10.2		
12+73.10	12+75.10	ROUTE CC	RT.					10.0	
12+83.09	12+91.55	ROUTE CC	RT.	9.1		9.1	16.4		INCLUDES SIDEWALK PERPENDICULAR TO EOS
12+86.55	12+91.55	ROUTE CC	RT.		5.7	5.7	10.2	10.0	
12+91.55	13+06.18	ROUTE CC	RT.		6.9	6.9	12.4		
13+55.93	13+66.59	ROUTE CC	RT.		5.7	5.7	10.3		
13+66.59	14+62.09	ROUTE CC	RT.	53.1		53.1	95.5		
14+72.52	16+16.04	ROUTE CC	RT.	85.5		85.5	139.5		
15+93.56	15+98.56	ROUTE CC	RT.		3.7	3.7	7.0	10.0	
16+67.95	16+96.89	ROUTE CC	RT.	17.4		17.4	31.4		
16+96.89	17+07.57	ROUTE CC	RT.		5.8	5.8	10.5		
16+90.38	16+95.38	ROUTE CC	RT.		5.7	5.7	10.2		FROM SIDEWALK TO EOS ROUTE CC
17+04.89	17+06.89	ROUTE CC	RT.					10.0	
16+90.46	16+95.46	ROUTE CC	RT.					10.0	
17+31.40	17+41.74	ROUTE CC	RT.		5.7	5.7	10.2		
17+31.74	17+33.74	ROUTE CC	RT.					10.0	
17+47.43	17+52.43	ROUTE CC	RT.		5.9	5.9	10.6		
17+47.51	17+52.51	ROUTE CC	RT.					10.0	
17+41.74	18+01.11	ROUTE CC	RT.	38.4		38.4	59.4		INCLUDES SIDEWALK PERP. TO ROUTE CC
18+44.49	18+77.17	ROUTE CC	RT.	23.4		23.4	33.3	10.0	
18+89.87	20+62.42	ROUTE CC	RT.	96.6		96.6	173.1	10.0	
20+21.08	20+26.08	ROUTE CC	RT.	7.9		7.9	14.3		
20+83.55	21+04.31	ROUTE CC	RT.	12.3		12.3	21.0		
21+43.16	21+49.16	ROUTE CC	RT.		9.3	9.3	14.0	10.0	FROM SIDEWALK TO EOS ROUTE CC
21+43.15	21+63.91	ROUTE CC	RT.	13.0		13.0	20.8		
21+63.91	21+74.27	ROUTE CC	RT.		5.7	5.7	10.2		
21+71.91	21+73.91	ROUTE CC	RT.					10.0	
SUBTOTALS				603.6	90.1	693.7	1219.4	170.0	

DATE	DESCRIPTION
5/5/25	SIDEWALK REROUTE

MISSOURI HIGHWAYS AND TRANSPORTATION COMMISSION



105 WEST CAPITOL
JEFFERSON CITY, MO 65102
1-888-ASK-MODOT (1-888-275-6636)

2215 Fairlawn Dr
Carthage, MO 64836
417.358.9551
COA# 00062
weareown.com



Engineering beyond.

IF A SEAL IS PRESENT ON THIS SHEET IT HAS BEEN ELECTRONICALLY SEALED AND DATED.

CONCRETE SIDEWALKS (TABLE 4 OF 9)									
STA.	STA.	ROUTE	LOCATION	4" SIDEWALK (SY)	CURB RAMP (SY)	4" TYPE 1 AGGR. (SY)	ADA LINEAR GRADING (LF)	TRUNCATED DOME (SF)	REMARKS
MENDON (CONTINUED)									
9+21.48	9+31.41	ROUTE CC	RT.	5.8		5.8	10.6		
9+22.44	9+24.24	ROUTE CC	RT.					10.0	
9+31.41	10+57.74	ROUTE CC	RT.	73.5		73.5	131.5		
10+57.74	10+69.29	ROUTE CC	RT.	6.1		6.11	11.1		
10+65.74	10+67.74	ROUTE CC	RT.					10.0	
10+91.46	11+05.13	ROUTE CC	RT.	6.6		6.6	11.8		
10+95.14	10+97.14	ROUTE CC	RT.					10.0	
11+05.13	12+38.06	ROUTE CC	RT.	74.0		74.0	132.9		
12+38.06	12+48.06	ROUTE CC	RT.		5.6	5.6	10.1		
12+46.06	12+48.06	ROUTE CC	RT.					10.0	
12+72.71	12+83.09	ROUTE CC	RT.		5.7	5.7	10.2		
12+73.10	12+75.10	ROUTE CC	RT.					10.0	
12+83.09	12+91.55	ROUTE CC	RT.	9.1		9.1	16.4		INCLUDES SIDEWALK PERPENDICULAR TO EOS
12+86.55	12+91.55	ROUTE CC	RT.		5.7	5.7	10.2	10.0	
12+91.55	13+06.18	ROUTE CC	RT.		6.9	6.9	12.4		
13+55.93	13+66.59	ROUTE CC	RT.		5.7	5.7	10.3		
13+66.59	14+62.09	ROUTE CC	RT.	53.1		53.1	95.5		
14+72.52	16+16.04	ROUTE CC	RT.	85.5		85.5	139.5		
15+93.56	15+98.56	ROUTE CC	RT.		3.7	3.7	7.0	10.0	
16+67.95	16+96.89	ROUTE CC	RT.	17.4		17.4	31.4		
16+96.89	17+07.57	ROUTE CC	RT.		5.8	5.8	10.5		
16+90.38	16+95.38	ROUTE CC	RT.		5.7	5.7	10.2		FROM SIDEWALK TO EOS ROUTE CC
17+04.89	17+06.89	ROUTE CC	RT.					10.0	
16+90.46	16+95.46	ROUTE CC	RT.					10.0	
17+31.40	17+41.74	ROUTE CC	RT.		5.7	5.7	10.2		
17+31.74	17+33.74	ROUTE CC	RT.					10.0	
17+47.43	17+52.43	ROUTE CC	RT.		5.9	5.9	10.6		
17+47.51	17+52.51	ROUTE CC	RT.					10.0	
17+41.74	18+01.11	ROUTE CC	RT.	38.4		38.4	59.4		INCLUDES SIDEWALK PERP. TO ROUTE CC
18+44.49	18+77.17	ROUTE CC	RT.	23.4		23.4	33.3	10.0	
18+89.87	20+62.42	ROUTE CC	RT.	96.6		96.6	173.1	10.0	
20+21.08	20+26.08	ROUTE CC	RT.	7.9		7.9	14.3		
20+83.55	21+04.31	ROUTE CC	RT.	12.3		12.3	21.0		
21+43.16	21+49.16	ROUTE CC	RT.		9.3	9.3	14.0	10.0	FROM SIDEWALK TO EOS ROUTE CC
21+43.15	21+63.91	ROUTE CC	RT.	13.0		13.0	20.8		
21+63.91	21+74.27	ROUTE CC	RT.		5.7	5.7	10.2		
21+71.91	21+73.91	ROUTE CC	RT.					10.0	
21+92.43	22+07.43	ROUTE CC	RT.		8.4	8.4	15.1		
21+92.43	21+94.43	ROUTE CC	RT.					10.0	
22+07.43	23+07.56	ROUTE CC	RT.	55.6		6.2	100.1		
23+21.56	25+02.84	ROUTE CC	RT.	90.0		10.0	161.9		
25+25.40	25+48.30	ROUTE CC	RT.	12.2		1.4	22.0		
25+44.09	27+09.52	ROUTE CC	RT.	81.0		9.0	145.0		
27+26.52	28+82.39	ROUTE CC	RT.	87.0		9.7	156.0		
SUBTOTALS				848.6	79.7	638.7	1628.6	160.0	



SHEET ADDED

SUMMARY OF QUANTITIES
SHEET 7 OF 20



DATE PREPARED 5/5/2025	
ROUTE VARIOUS	STATE MO
DISTRICT NW	SHEET NO. 3A
COUNTY CHARITON / CARROLL	
JOB NO. JNW0030	
CONTRACT ID.	
PROJECT NO.	
BRIDGE NO.	

DATE	DESCRIPTION
5/5/25	SIDEWALK REROUTE

MISSOURI HIGHWAYS AND TRANSPORTATION COMMISSION



105 WEST CAPITOL
JEFFERSON CITY, MO 65102
1-888-ASK-MODOT (1-888-275-6636)

2215 Fairlawn Dr
Carthage, MO 64836
417.358.9551
COA# 00062
weareown.com



Engineering beyond.

IF A SEAL IS PRESENT ON THIS SHEET IT HAS BEEN ELECTRONICALLY SEALED AND DATED.

CONCRETE SIDEWALKS (TABLE 5 OF 9)									
STA.	STA.	ROUTE	LOCATION	4" SIDEWALK (SY)	CURB RAMP (SY)	4" TYPE 1 AGGR. (SY)	ADA LINEAR GRADING (LF)	TRUNCATED DOME (SF)	REMARKS
MENDON (CONTINUED)									
21+92.43	22+07.43	ROUTE CC	RT.		8.4	8.4	15.1		
21+92.43	21+94.43	ROUTE CC	RT.					10.0	
22+07.43	23+07.56	ROUTE CC	RT.	55.6		55.6	100.1		
23+21.56	25+02.84	ROUTE CC	RT.	90.0		90.0	161.9		
25+25.40	25+48.30	ROUTE CC	RT.	12.2		12.2	22.0		
25+48.30	25+56.79	ROUTE CC	RT.		6.3	6.3	11.3		
25+53.97	25+55.23	ROUTE CC	RT.					10.0	
HALE									
27+52.40	30+22.81	ROUTE 139	LT.	149.8		149.8	270.4		
30+17.81	30+30.48	ROUTE 139	LT.		6.8	6.8	12.7		
30+27.81	30+29.81	ROUTE 139	LT.					10.0	
30+17.75	30+22.75	ROUTE 139	LT.	8.6		8.6	30.9		
KEYTESVILLE									
9+92.87	10+63.62	ROUTE K	LT.	39.8		39.8	70.8		
10+63.62	10+73.62	ROUTE K	LT.		5.6	5.6	10.0		
10+71.62	10+73.62	ROUTE K	LT.					10.0	
NORBORNE									
1204+96.89	1205+82.46	ROUTE D	LT.	47.8		47.8	85.6		
1205+82.46	1205+93.23	ROUTE D	LT.		5.8	5.8	10.8		
1205+90.46	1205+92.46	ROUTE D	LT.					10.0	
1206+14.48	1206+26.38	ROUTE D	LT.		6.3	6.3	11.9		
1206+17.17	1206+19.17	ROUTE D	LT.					10.0	INCLUDES SIDEWALK TO EXIST. SIDEWALK AT RESIDENCE
1206+26.38	1206+77.86	ROUTE D	LT.	29.0		29.0	71.6		
1206+88.19	1207+35.77	ROUTE D	LT.	26.9		26.9	47.6		
1207+52.67	1208+24.26	ROUTE D	LT.	39.8		39.8	71.6		
1208+36.53	1210+16.50	ROUTE D	LT.	100.2		100.2	180.0		
1210+62.45	1211+06.58	ROUTE D	LT.	24.5		24.5	44.1	10.0	
1211+06.58	1211+51.75	ROUTE D	LT.	25.4		25.4	45.2		
1211+66.75	1212+11.24	ROUTE D	LT.	19.1		19.1	44.5		
1212+11.24	1212+72.19	ROUTE D	LT.	35.8		35.8	60.9		
1212+67.09	1212+72.09	ROUTE D	LT.		5.6	5.6	10.2		
1212+67.01	1212+72.01	ROUTE D	LT.					10.0	
1217+83.23	1217+99.76	ROUTE D	LT.		21.9	21.9	26.2		
1217+83.30	1217+90.53	ROUTE D	LT.					21.6	
1217+99.76	1218+91.31	ROUTE D	LT.	74.7		74.7			
1218+81.30	1218+91.36	ROUTE D	LT.		6.2	6.2	10.1		
1218+89.30	1218+91.36	ROUTE D	LT.					10.0	
1219+05.32	1219+23.24	ROUTE D	LT.		9.6	9.6	17.9		
1219+06.54	1219+08.53	ROUTE D	LT.					10.0	
1219+49.53	1219+69.52	ROUTE D	LT.	9.0		9.0			
1219+79.67		ROUTE D	LT.		30.7	30.7	65.4	10.0	
1220+70.67	1220+90.67	ROUTE D	LT.		18.0	18.0	20.0		
1220+75.67	1220+80.67	ROUTE D	LT.					10.0	
1220+90.67	1221+43.83	ROUTE D	LT.	45.5		45.5	53.2	10.0	
SUBTOTALS				833.7	131.1	964.8	1582.0	151.6	

DESCRIPTION	
SIDEWALK	REROUTE

MISSOURI HIGHWAYS AND TRANSPORTATION COMMISSION



105 WEST CAPITOL
JEFFERSON CITY, MO 65102
1-888-ASK-MODOT (1-888-275-6636)

2215 Fairlawn Dr
Carthage, MO 64836
417.358.9551
COA# 00062
weareown.com



Engineering beyond.

IF A SEAL IS PRESENT ON THIS SHEET IT HAS BEEN ELECTRONICALLY SEALED AND DATED.

CONCRETE SIDEWALKS (TABLE 9 OF 9)									
STA.	STA.	ROUTE	LOCATION	4" SIDEWALK (SY)	CURB RAMP (SY)	4" TYPE 1 AGGR. (SY)	ADA LINEAR GRADING (LF)	TRUNCATED DOME (SF)	REMARKS
BOSWORTH (CONTINUED)									
452+16.46	452+26.34	ROUTE M	RT.	6.6		6.6	9.9		
597+02.57	597+35.44	ROUTE 139	LT.	18.9		18.9	36.4		
597+33.44	597+35.44	ROUTE 139	LT.					10.0	
597+57.38	597+88.36	ROUTE 139	LT.	146.9		146.9	31.0		
597+57.92	597+59.92	ROUTE 139	LT.					10.0	
597+98.79	600+98.58	ROUTE 139	LT.	168.8		168.8	299.8		
600+93.56	600+98.56	ROUTE 139	LT.		6.3	6.3	12.4		
600+93.54	600+98.54	ROUTE 139	LT.					10.0	
604+53.03	605+28.42	ROUTE 139	LT.	3.2		3.2	5.7		
604+54.14	604+59.14	ROUTE 139	LT.		9.0	9.0	17.2		
604+53.90	604+58.90	ROUTE 139	LT.					10.0	
596+59.02	596+69.56	ROUTE 139	RT.		05.6	05.6	10.0		
596+62.62	596+64.01	ROUTE 139	RT.					10.0	
596+69.56	597+11.51	ROUTE 139	RT.	29.7		29.7	63.5		
597+22.50	598+36.21	ROUTE 139	RT.	64.4		64.4	113.7		
598+48.21	601+03.39	ROUTE 139	RT.	149.4		149.4	255.2		
601+03.39	601+13.56	ROUTE 139	RT.		5.6	5.6	10.2		
600+93.43	600+98.43	ROUTE 139	RT.		5.6	5.6	10.0		
600+93.45	600+98.45	ROUTE 139	RT.					10.0	
601+27.55	601+37.63	ROUTE 139	RT.		5.6	5.6	10.1		
601+27.66	601+29.63	ROUTE 139	RT.					9.9	
601+37.63	602+24.94	ROUTE 139	RT.	48.6		48.6	87.5		
602+37.53	603+46.77	ROUTE 139	RT.	60.3		60.3	110.4		
603+59.03	604+57.82	ROUTE 139	RT.	52.4		52.4	113.8		
604+53.16	604+58.16	ROUTE 139	RT.		6.3	6.3	12.2		
604+53.31	604+58.31	ROUTE 139	RT.					10.0	
HALE									
27+52.40	30+30.38	ROUTE 139	LT.	159.0	7.2	18.5	285.5	10.0	
			SUBTOTALS	908.2	51.2	811.6	1494.5	89.9	
CONCRETE SIDEWALKS TABLE 1			SUBTOTALS	856.0	80.3	938.3	1697.2	120.0	
CONCRETE SIDEWALKS TABLE 2			SUBTOTALS	1506.7	77.1	1583.8	2628.9	116.8	
CONCRETE SIDEWALKS TABLE 3			SUBTOTALS	1416.7	70.6	1487.3	2445.2	130.0	
CONCRETE SIDEWALKS TABLE 4			SUBTOTALS	603.6	90.1	693.7	1219.4	170.0	
CONCRETE SIDEWALKS TABLE 5			SUBTOTALS	833.7	131.1	964.8	1582.0	151.6	
CONCRETE SIDEWALKS TABLE 6			SUBTOTALS	1059.4	111.6	1170.9	1998.4	124.1	
CONCRETE SIDEWALKS TABLE 7			SUBTOTALS	935.8	146.7	1082.6	1826.0	168.0	
CONCRETE SIDEWALKS TABLE 8			SUBTOTALS	1134.5	96.3	1230.8	1796.6	192.0	
CONCRETE SIDEWALKS TABLE 9			SUBTOTALS	908.2	51.2	811.6	1494.5	89.9	
			PAY TOTALS	9255	855	9964	16688	1262	

DATE		DESCRIPTION	
5/5/25		SIDEWALK REROUTE	

MISSOURI HIGHWAYS AND TRANSPORTATION COMMISSION



105 WEST CAPITOL
JEFFERSON CITY, MO 65102
1-888-ASK-MODOT (1-888-275-6636)

2215 Fairlawn Dr
Carthage, MO 64836
417.358.9551
COA# 00062
weareown.com



Engineering beyond.

IF A SEAL IS PRESENT ON THIS SHEET IT HAS BEEN ELECTRONICALLY SEALED AND DATED.

PAVED APPROACH (TABLE 2 OF 3)											
STA.	ROUTE	LOCATION	WIDTH (FT.)	GRADE (%)	7" PAVED APPROACH (SY)	8" PAVED APPROACH (SY)	4" TYPE 1 AGGR. (SY)	GRAVEL (A) OR CRUSHED STONE (B) (SY)	GROUP C PIPE 12" (LF)	GROUP C PIPE 15" (LF)	REMARKS
MENDON											
12+85.55	ROUTE CC	LT.	7			9.3	9.3				EOP TO SIDEWALK (12' LONG)
13+75.60	ROUTE CC	LT.	VARIES			9.2	9.2	1.6			
14+13.39	ROUTE CC	LT.	18.8			14.9	14.9	10.1			
15+66.13	ROUTE CC	LT.	18.8			14.6	14.6	4.2			
16+88.54	ROUTE CC	LT.	7			13.9	13.9				EOP TO SIDEWALK (17.9' LONG)
17+47.04	ROUTE CC	LT.	7			13.3	13.3				EOP TO SIDEWALK (17.3' LONG)
18+13.24	ROUTE CC	LT	7			14.5	14.5				EOP TO SIDEWALK (18.2' LONG)
18+57.87	ROUTE CC	LT.	7			9.2	9.2				EOP TO SIDEWALK (11.6' LONG)
20+03.68	ROUTE CC	LT.	7			14.9	14.9				EOP TO SIDEWALK (19.1' LONG)
20+42.18	ROUTE CC	LT.	VARIES			7.3	7.3	0.9			
21+19.58	ROUTE CC	LT.	16			13.7	13.7	2.9			
21+42.66	ROUTE CC	LT.	7			9.4	9.4				EOP TO SIDEWALK (12.1' LONG)
27+08.79	ROUTE CC	LT.	9.3			7.3	7.3				
30+44.10	ROUTE CC	LT.	16			12.4	12.4				
31+88.07	ROUTE CC	LT.	12			9.3	9.3	7.0			
12+85.55	ROUTE CC	RT.	7			8.3	8.3				EOP TO SIDEWALK (10.7' LONG)
13+00.79	ROUTE CC	RT.	VARIES			49.7	49.7				
14+62.09	ROUTE CC	RT.	10.5			8.1	8.1	2.0			
15+92.56	ROUTE CC	RT.	7			11.7	11.7				EOP TO SIDEWALK (14.5' LONG)
16+16.04	ROUTE CC	RT.	51.9			43.1	43.1	37.0			
16+89.47	ROUTE CC	RT.	7			14.1	14.1				EOP TO SIDEWALK (18.1' LONG)
17+46.52	ROUTE CC	RT.	7			9.8	9.8				EOP TO SIDEWALK (12.7' LONG)
18+01.11	ROUTE CC	RT.	43.3			25.4	25.4	17.5			
18+66.15	ROUTE CC	RT.	7			12.2	12.2				EOP TO SIDEWALK (15.6' LONG)
18+77.17	ROUTE CC	RT.	12.7			9.9	9.9	12.2			
20+20.08	ROUTE CC	RT.	7			12.2	12.2				EOP TO SIDEWALK (15.6' LONG)
20+62.27	ROUTE CC	RT.	VARIES			15.0	15.0	1.9			
21+04.31	ROUTE CC	RT.	38.8			40.8	40.8	25.8			
21+42.66	ROUTE CC	RT.	7			12.1	12.1				EOP TO SIDEWALK (15.5' LONG)
23+07.56	ROUTE CC	RT.	14		10.9		10.9				
25+03.70	ROUTE CC	RT.	14		10.9		10.9				
NORBORNE											
1206+77.85	ROUTE D	LT.	10.3		8.0		8.0				
1207+35.76	ROUTE D	LT.	17		13.1		13.1				
1208+24.25	ROUTE D	LT.	12.3		9.5		9.5				
1210+16.49	ROUTE D	LT.	31		24.1		24.1				
1210+47.53	ROUTE D	LT.	15		11.7		11.7				
1210+92.61	ROUTE D	LT.	7			10.0	10.0				EOP TO SIDEWALK (13.0' LONG)
1211+51.74	ROUTE D	LT.	15		11.7	11.7	23.3				
1212+01.21	ROUTE D	LT.	10		7.8	7.8	15.6				
1217+83.29	ROUTE D	LT.	7			6.3	6.3				EOP TO SIDEWALK (9.2' LONG)
1219+26.53	ROUTE D	LT.	VARIES			36.0	36.0				
1219+94.20	ROUTE D	LT.	7			6.3	6.3				EOP TO SIDEWALK (8.7' LONG)
1220+81.20	ROUTE D	LT.	7			6.1	6.1				EOP TO SIDEWALK (8.9' LONG)
1221+25.32	ROUTE D	LT.	7			6.8	6.8				EOP TO SIDEWALK (9.1' LONG)
1225+37.86	ROUTE D	LT.	VARIES			31.0	31.0				
1226+07.89	ROUTE D	LT.	VARIES			28.4	28.4				
1226+59.44	ROUTE D	LT	51.6			40.2	40.2				
1229+57.19	ROUTE D	LT.	18.4		14.3		14.3				
1230+57.69	ROUTE D	LT.	11.3		8.8		8.8	3.7			
1234+71.72	ROUTE D	LT.	22		17.1		17.1				
				SUBTOTALS	148.0	636.2	784.2	126.9	0.0	0.0	

CULVERTS											
STA.	ROUTE	LOCATION	GROUP C PIPE 8" (LF)	GROUP C PIPE 12" (LF)	GROUP C PIPE 15" (LF)	GROUP C PIPE 18" (LF)	GROUP C PIPE 24" (LF)	GROUP C PIPE 30" (LF)	CLASS 3 EXC. (CY)	ROCK LINING (CY)	REMARKS
SUMNER											
0+24.79	ROUTE EE	42.51' LT.				17			3		
4+55.69	ROUTE EE	46.14' LT.		16					1		
4+58.28	ROUTE EE	42.63' RT.	13						1		
4+97.52	ROUTE EE	42.49' RT.	16						1		
6+58.02	ROUTE EE	42.94' RT.	13						1		
9+08.84	ROUTE EE	33.50' LT.			16				1		
9+09.99	ROUTE EE	32.32' RT.	14						1		
9+18.00	ROUTE EE	50.12 LT.	13						1		
14+08.59	ROUTE EE	44.11' RT.		14					1		
17+15.79	ROUTE EE	63.18' LT.			40				14		
19+94.77	ROUTE EE	54.07' LT.		15					1		
ROTHVILLE											
52+12.98	ROUTE E	27.37' RT.			20				4		
68+48.56	ROUTE E	16.31' LT.		18					2		
68+48.72	ROUTE E	16.50' RT.		17					1		
MENDON											
8+92.12	ROUTE CC	55.41' RT.			21				2		
9+27.90	ROUTE CC	47.92' RT.			12				2		
12+44.78	ROUTE CC	46.00' RT.	10						1		
12+79.59	ROUTE CC	46.00' RT.			9				1		
12+89.03	ROUTE CC	31.92' LT.			15				1		
12+89.05	ROUTE CC	34.75' RT.			16				1		
15+96.06	ROUTE CC	35.19' RT.		14					1		
21+46.16	ROUTE CC	34.28' LT.			11				3		
21+64.59	ROUTE CC	46.00' RT.			12				2		
25+48.41	ROUTE CC	16.96' RT.			10				2		
27+96.03	ROUTE CC	36.00' LT.					33		9	5	3 PIPES AT 11' EACH
NORBORNE											
1206+24.32	ROUTE D	24.54' RT.			15				1		
1227+37.73	ROUTE D	26.10' LT.	12	0					2		
BOSWORTH											
443+19.50	ROUTE 139	26.41' RT.		15					1		
600+95.10	ROUTE 139	25.46' LT.			9						
601+43.46	ROUTE 139	38.08' RT.						24	1		
HALE											
29+12.95	ROUTE 139	35.10' LT.			16				4		
PAY TOTALS			91	109	222	17	33	24	67	5	

DATE	DESCRIPTION
5/5/25	SIDEWALK REROUTE

MISSOURI HIGHWAYS AND TRANSPORTATION COMMISSION




105 WEST CAPITOL
JEFFERSON CITY, MO 65102
1-888-ASK-MODOT (1-888-275-6636)



Engineering beyond.

2215 Fairlawn Dr
Carthage, MO 64836
417.358.9551
COA# 00062
weareown.com

IF A SEAL IS PRESENT ON THIS SHEET IT HAS BEEN ELECTRONICALLY SEALED AND DATED.

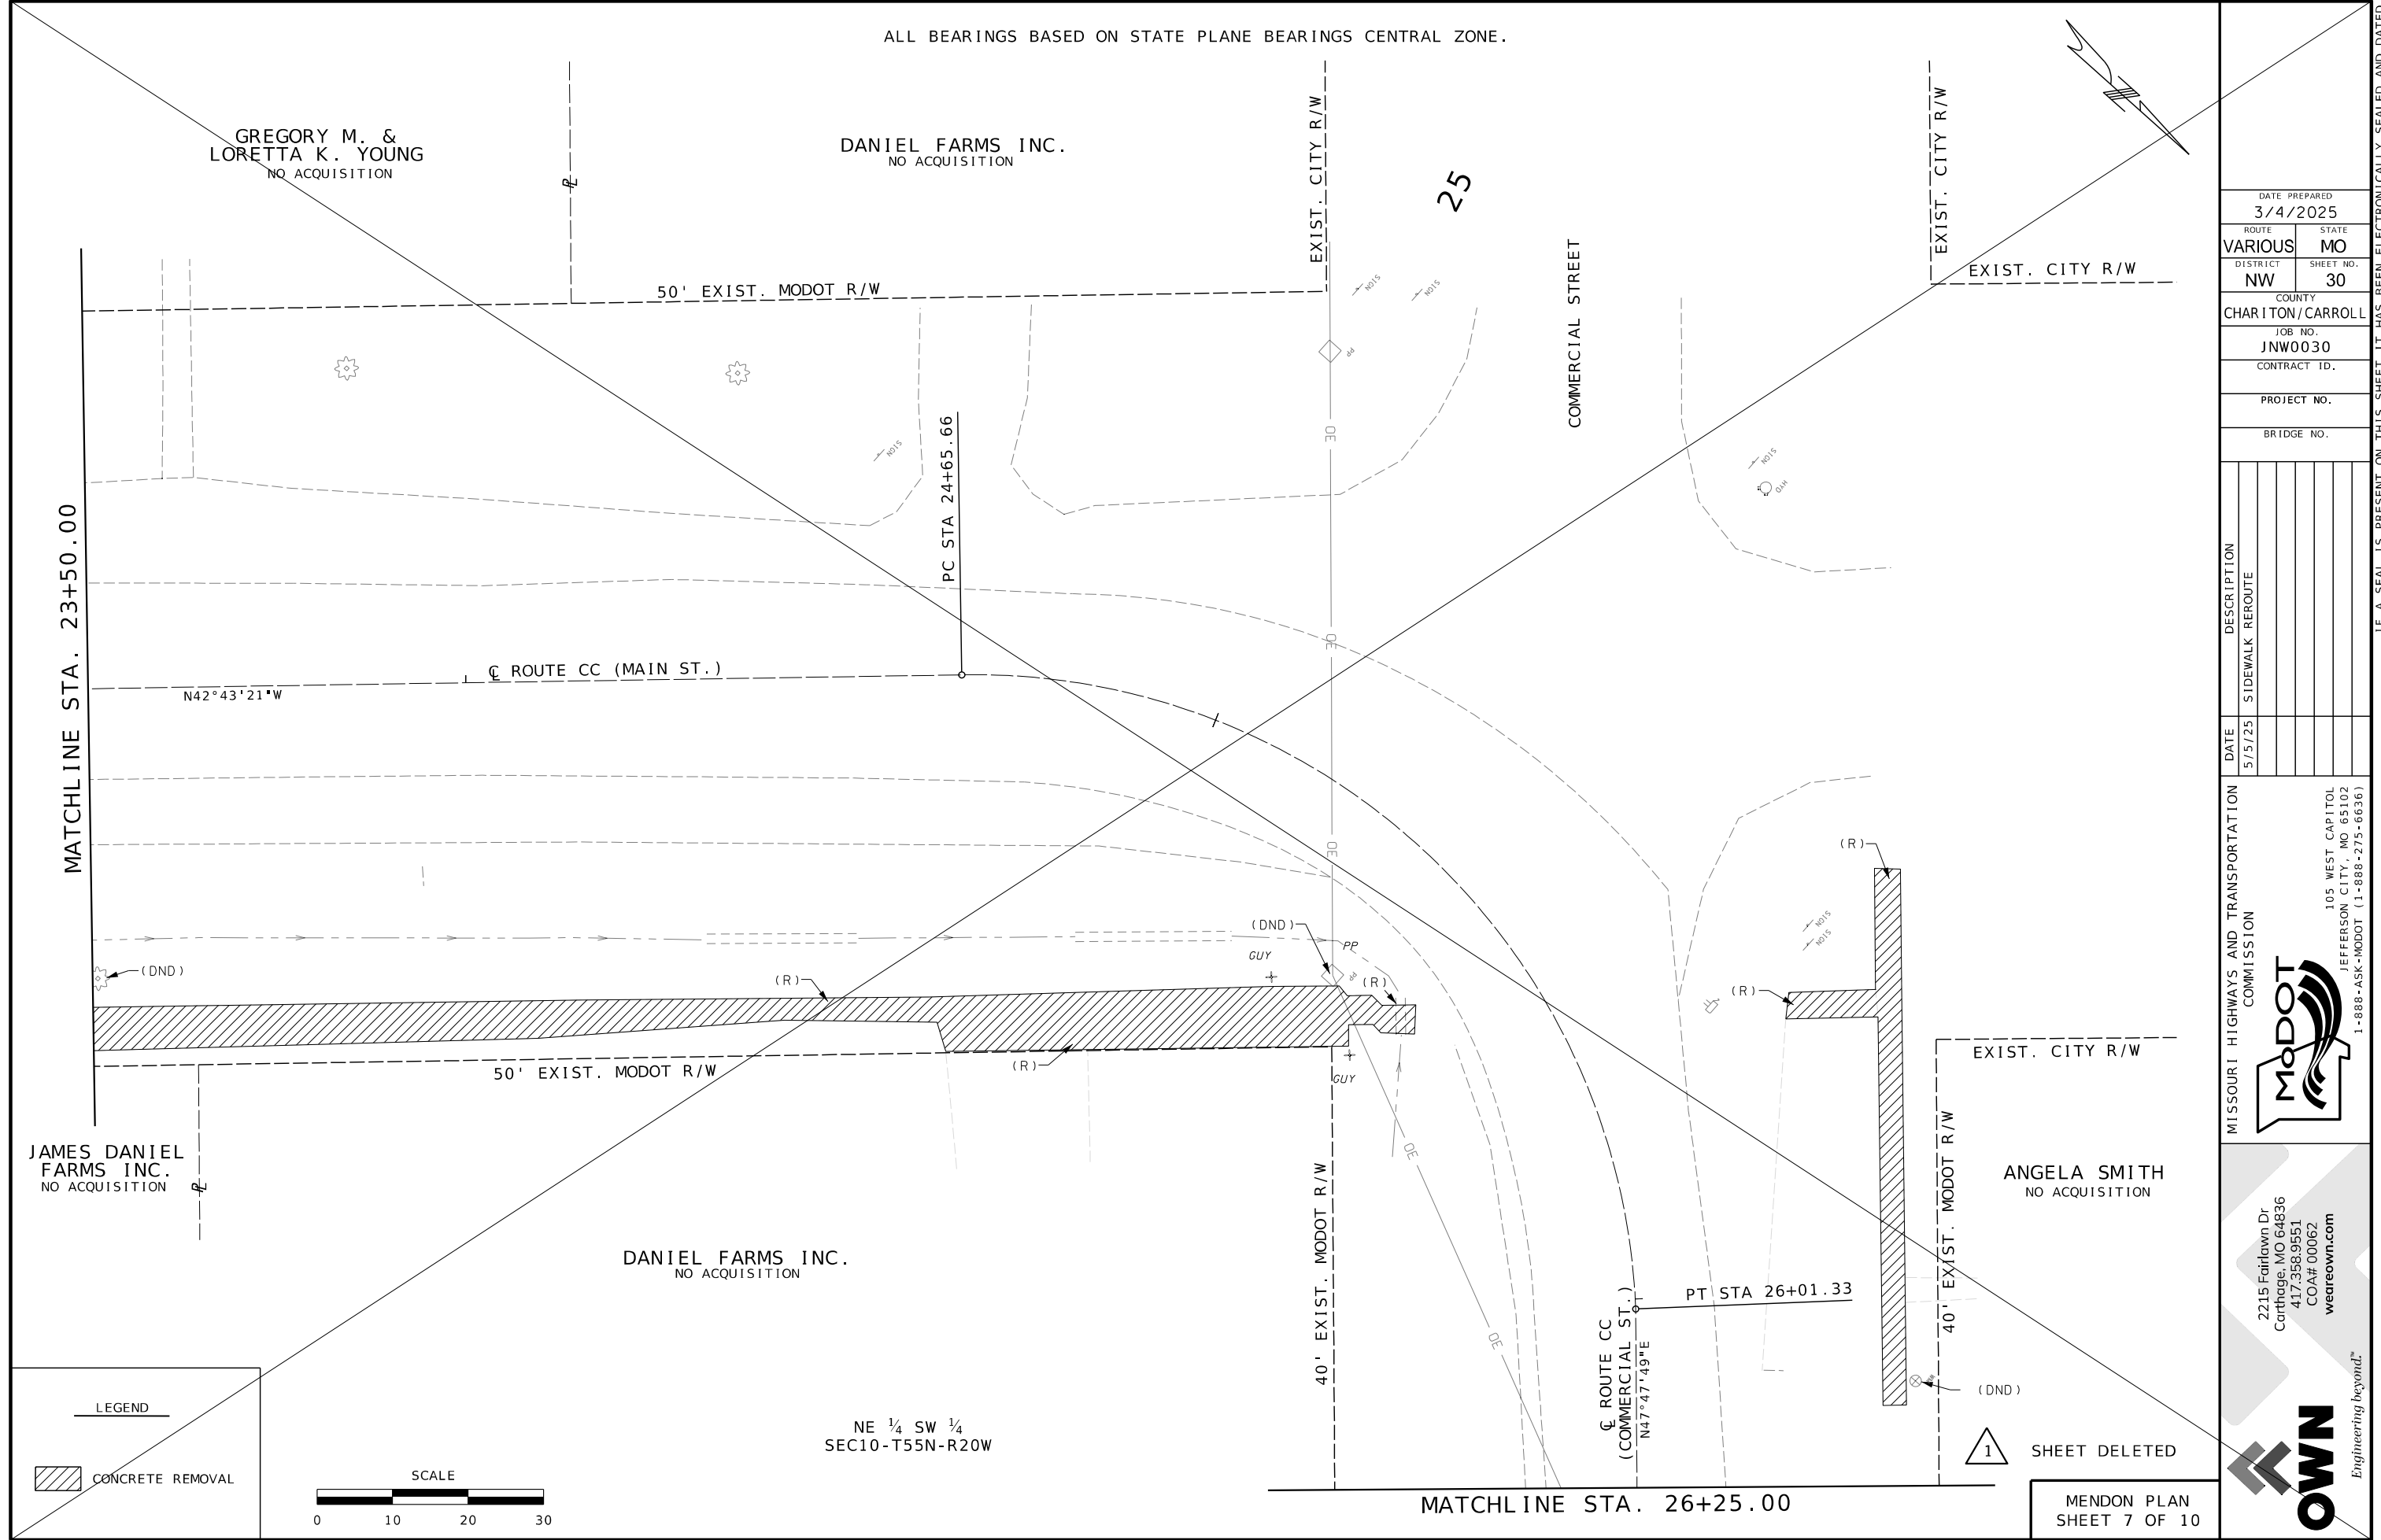

DATE PREPARED 3/4/2025	
ROUTE VARIOUS	STATE MO
DISTRICT NW	SHEET NO. 30
COUNTY CHARITON / CARROLL	
JOB NO. JNW0030	
CONTRACT ID.	
PROJECT NO.	
BRIDGE NO.	

DATE	DESCRIPTION
5/5/25	SIDEWALK REROUTE

MISSOURI HIGHWAYS AND TRANSPORTATION
COMMISSION

MoDOT

2215 Fairlawn Dr
Carthage, MO 64836
417.358.9551
COA# 00062
wearemo.com

105 WEST CAPITOL
JEFFERSON CITY, MO 65102
1-888-ASK-MODOT (1-888-275-6636)

OWN
Engineering beyond.

IF A SEAL IS PRESENT ON THIS SHEET IT HAS BEEN ELECTRONICALLY SEALED AND DATED.

DANIEL FARMS INC.
NO ACQUISITION

50' EXIST. MODOT R/W

25

COMMERCIAL STREET

EXIST. CITY R/W

EXIST. CITY R/W

N42°43'21"W

DE

~~DE~~

- DE - /

(DND)—

GUY

|
|
| GUY
|

40' EXIST. MODOT R/W

ROUTE CC
(COMMERCIAL ST.)

PT STA 26+01.33

(UIP)-

40' EXIST. MODOT R/W

EXIST. CITY R/W

ANGELA SMITH
NO ACQUISITION

△ SHEET ADDED

MENDON PLAN
SHEET 7 OF 10

DANIEL FARMS INC.
NO ACQUISITION

LEGEND

 CONCRETE REMOVAL

SCALE

0 10 20 30

 STATE OF MISSOURI SEAL MATHLOCK NUMBER E-27133 PROFESSIONAL ENGINEER THIS SHEET HAS BEEN SIGNED, SEALED AND DATED ELECTRONICALLY.		DATE PREPARED 3/4/2025	
		ROUTE VARIOUS	STATE MO
DISTRICT NW		SHEET NO. 30A	
COUNTY CHAR I TON / CARROLL			
JOB NO. JNW0030			
CONTRACT ID.			
PROJECT NO.			
BRIDGE NO.			
DESCRIPTION			
DATE	5/5/25	SIDEWALK	REROUTE
MISSOURI HIGHWAYS AND TRANSPORTATION COMMISSION		 105 WEST CAPITAL JEFFERSON CITY, MO 65102 1-888-ASK-MODOT (1-888-275-6636)	
 2215 Fairlawn Dr Carthage, MO 64836 417-358-9551 COA# 00062 weareown.com		 Engineering beyond.SM	

IF A SEAL IS PRESENT ON THIS SHEET IT HAS BEEN ELECTRONICALLY SEALED AND DATED:

ALL BEARINGS BASED ON STATE PLANE BEARINGS CENTRAL ZONE.

NE $\frac{1}{4}$ SW $\frac{1}{4}$
SEC10-T55N-R20W

29

CITY OF MENDON

1400 SF TEMP. ESM'T.
19600.0 SF (0.45 AC) REMAINING

ANGELA SMITH
NO ACQUISITION

ALLEY

EXIST. CITY R/W

EXIST. CITY R/W

EXIST CITY B/W

LONG STREET

MATCHLINE STA. 28+90.00

MATCHLINE STA. 26+25.00

40' EXIST. MODOT R/W.

40' EXIST. MODOT R/W

TEMP. CONST.
ESM'T.~~(R)~~

(U)

510

~~ROUTE CC (COMMERCIAL ST.)~~

N47°47'49"E

40' EXIST. MODOT R/W

40' EXIST. MODOT R/W

~~DANIELS FARMS INC.~~
NO ACQUISITION

DANIELS FARMS LLC.
NO ACQUISITION

NE $\frac{1}{4}$ SW $\frac{1}{4}$
SEC10-T55N-R20W

SHEET DELETED

MENDON PLAN
SHEET 8 OF 10

DATE PREPARED	
3/4/2025	
ROUTE	STATE
VARIOUS	MO
DISTRICT	SHEET NO.
NW	31
COUNTY	
CHARITON / CARROLL	
JOB NO.	
JNW0030	
CONTRACT ID.	
PROJECT NO.	
BRIDGE NO.	

[illegible]MISSOURI HIGHWAYS AND TRANSPORTATION
COMMISSION

COMMISSION

2215 Fairlawn Dr
Carthage, MO 64836
417.358.9551
COA# 00062
weareown.com

COA# 00062
weareown.com

Engineering beyond.™


[illegible]

LEGEND

~~CONCRETE REMOVAL~~

SCALE



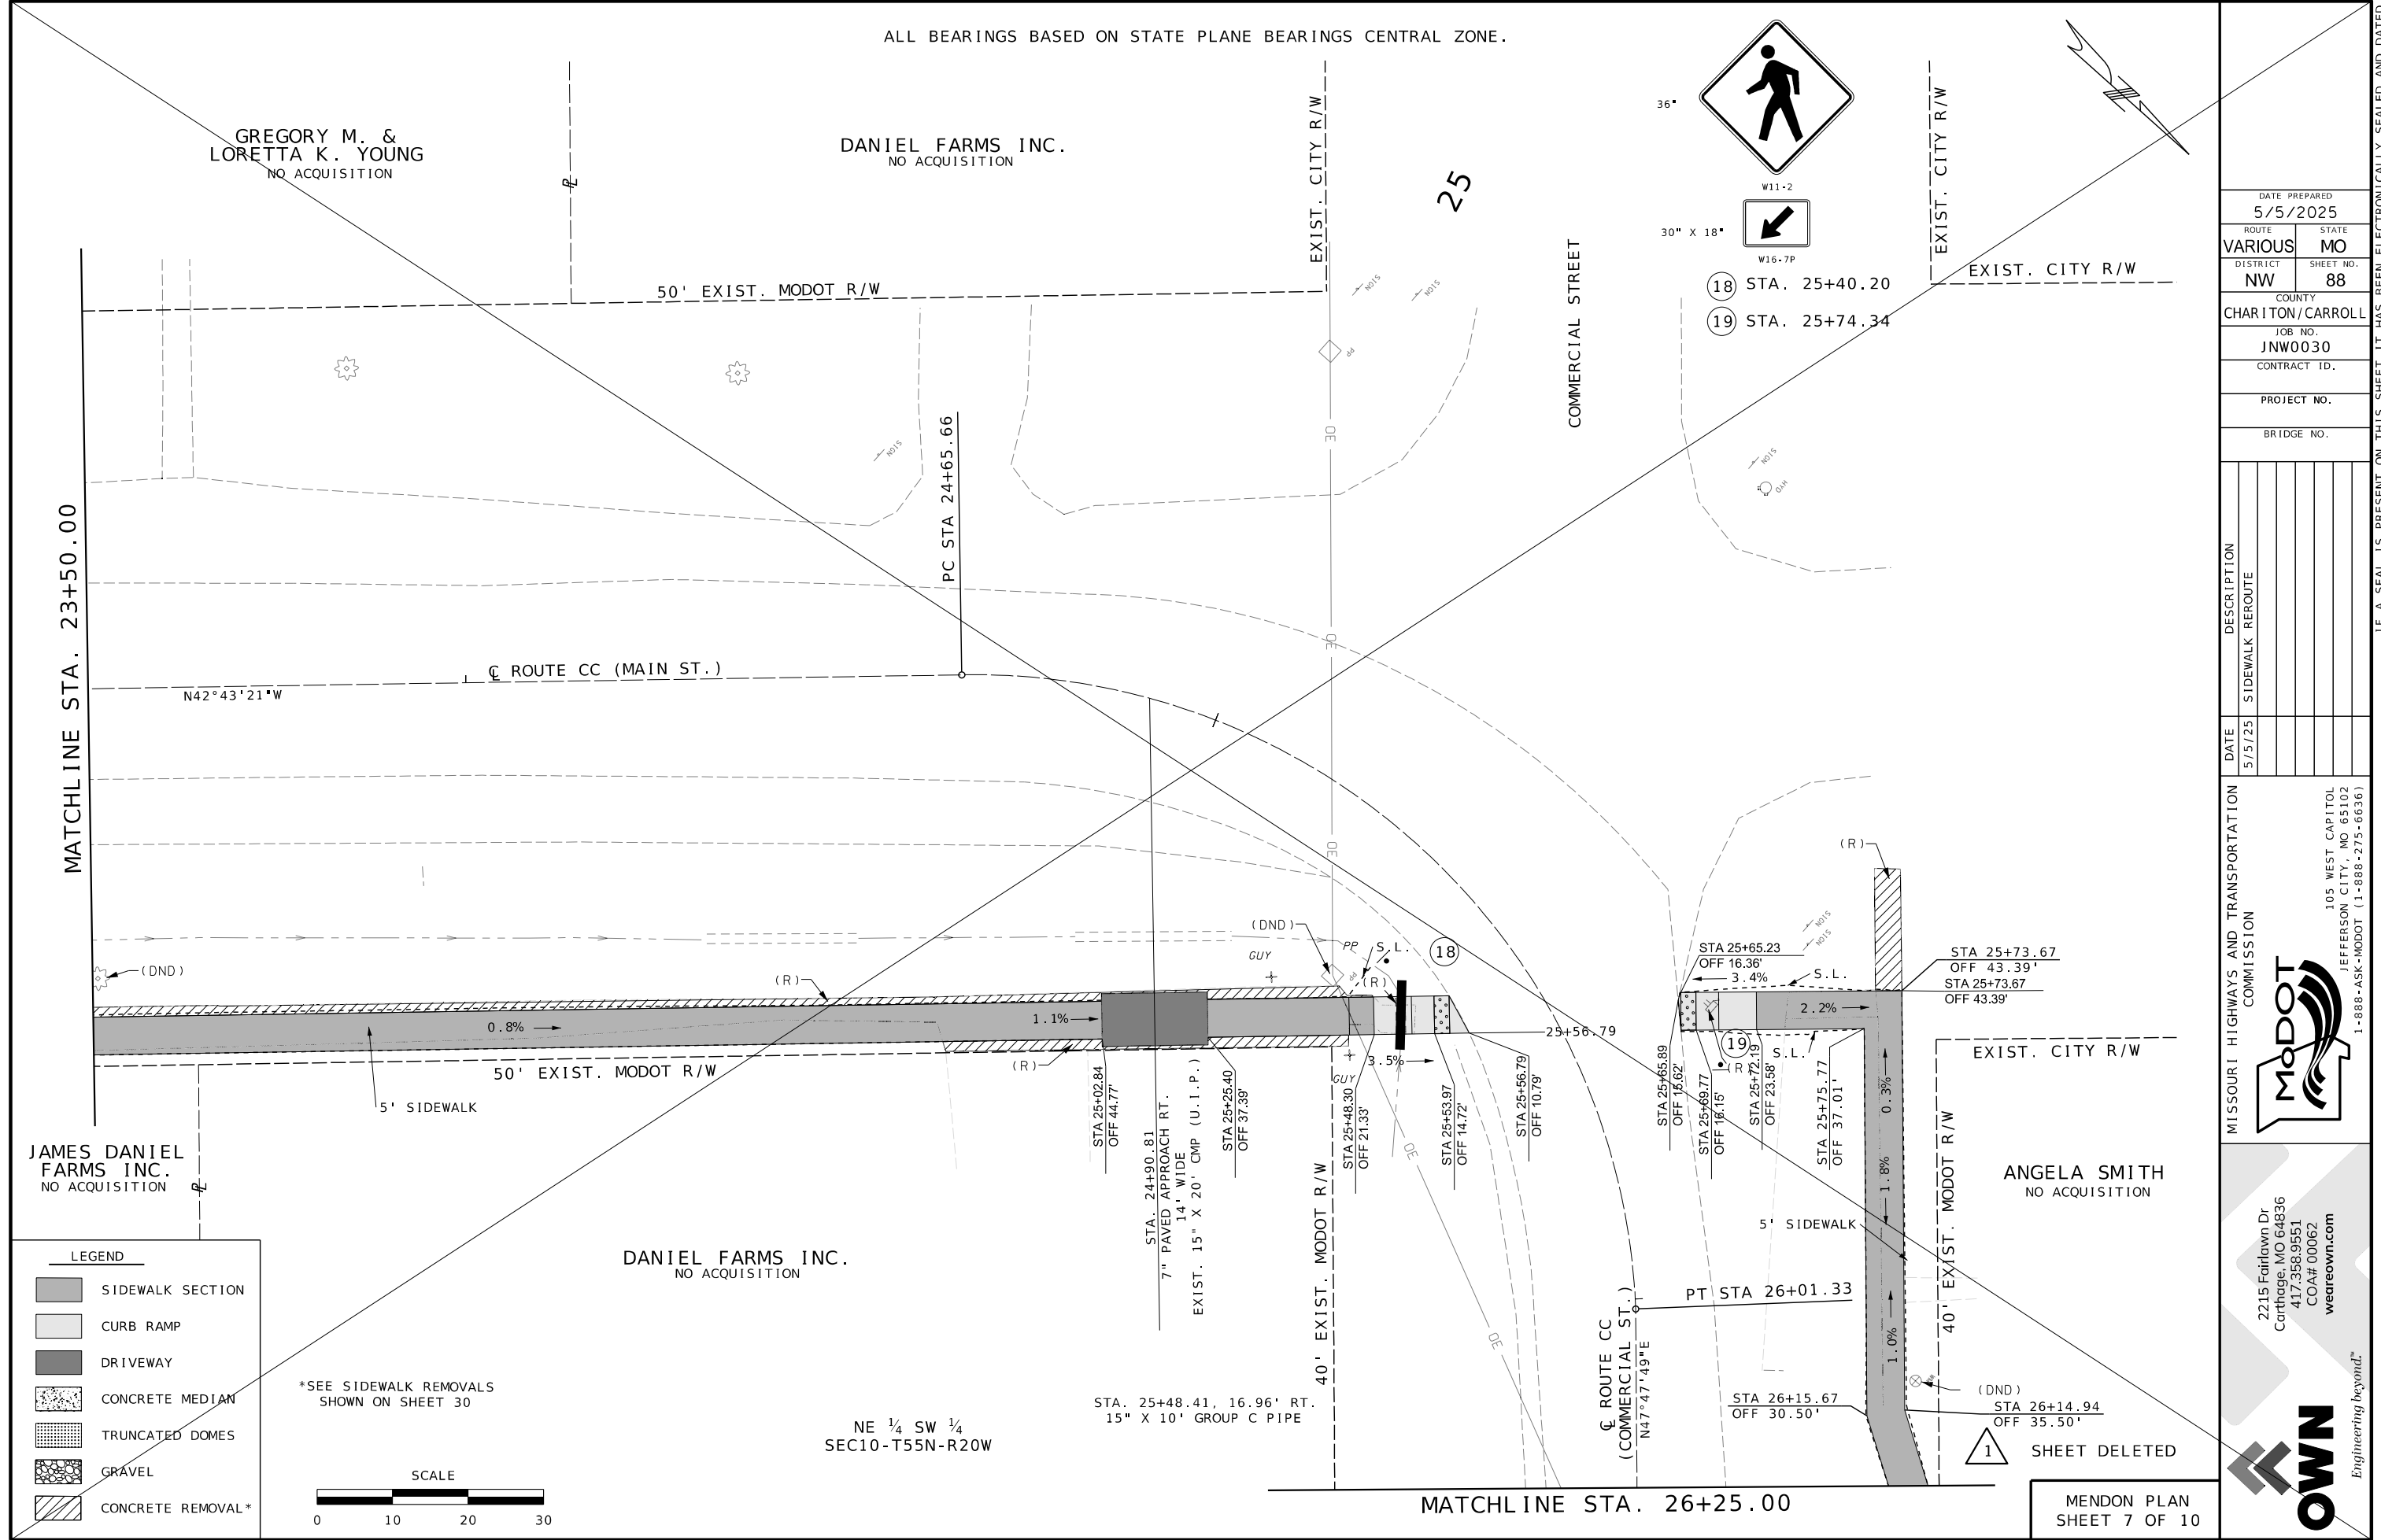

LEGEND

- SIDEWALK SECTION
- CURB RAMP
- DRIVEWAY
- CONCRETE MEDIAN
- TRUNCATED DOMES
- GRAVEL
- CONCRETE REMOVAL*

*SEE SIDEWALK REMOVALS
SHOWN ON SHEET 30

SCALE

0 10 20 30

DANIEL FARMS INC.
NO ACQUISITION

[illegible]

Page 10 of 10



OWN
Engineering beyond[®]

MATCHLINE STA. 23+50.00

25

25

COMMERCIAL STREET

EXIST. CITY R/W

EXIST. CITY R/W

JAMES DANIEL
FARMS INC.
NO ACQUISITION

DANIEL FARMS INC.
NO ACQUISITION

PI	25+51.37	STA
PC	24+65.66	
PT	26+01.33	
Δ	88°47'10.8" (RT)	
D	65°26'27.9"	
L	135.67' (ARC)	
T	85.72'	
R	87.55'	

STA. 25+48.41, 16.96' RT.
15" X 10' GROUP C PIPE

40' EXIST. MODOT R/W

ROUTE CC
(COMMERCIAL ST.)

--- EXIST. MODOT R/W ---

EXIST. CITY R/W

ANGELA SMITH
NO ACQUISITION


SHEET ADDED

MENDON PLAN
SHEET 7 OF 10

MATCHLINE STA. 26+25.00


*SEE SIDEWALK REMOVALS
SHOWN ON SHEET 30

SCALE

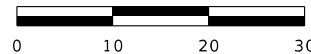

- LEGEND**

	SIDEWALK SECTION
	CURB RAMP
	DRIVEWAY
	CONCRETE MEDIAN
	TRUNCATED DOMES
	GRAVEL
	CONCRETE REMOVAL *

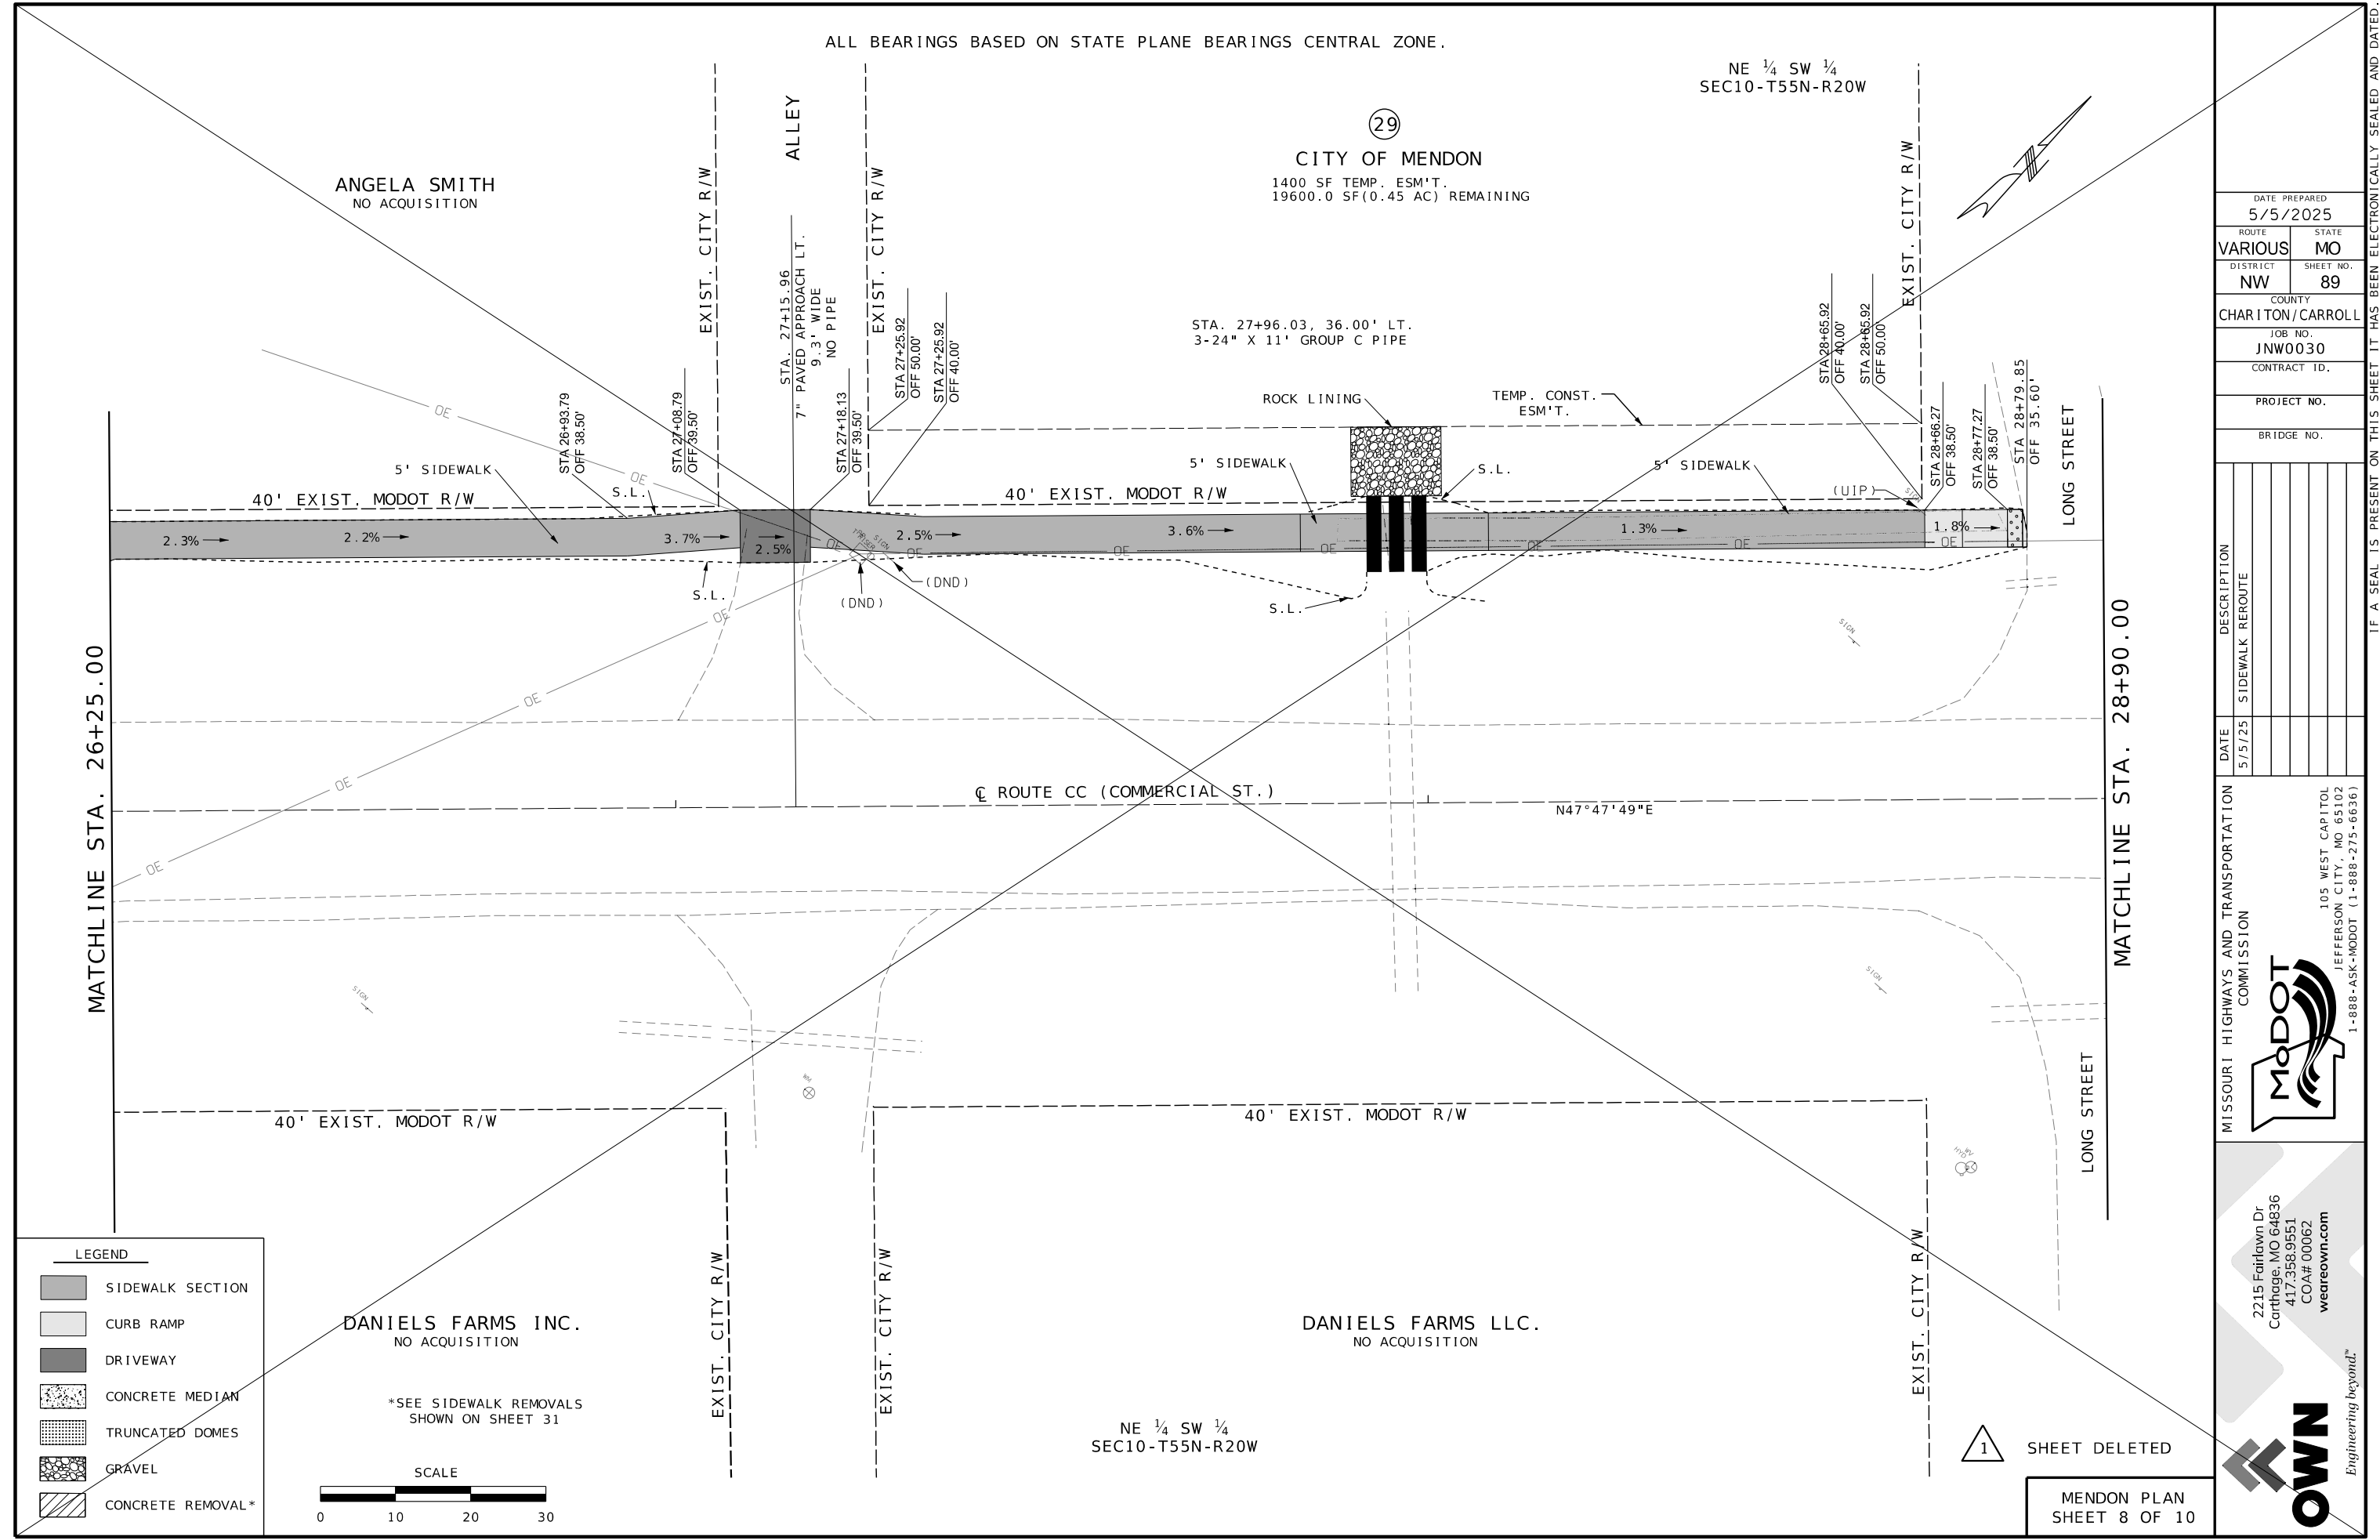


DATE PREPARED 5/5/2025	
ROUTE VARIOUS	STATE MO
DISTRICT NW	SHEET NO. 89
COUNTY CHARITON / CARROLL	
JOB NO. JNW0030	
CONTRACT ID.	
PROJECT NO.	
BRIDGE NO.	
DATE 5/5/25	DESCRIPTION SIDEWALK REROUTE
MISSOURI HIGHWAYS AND TRANSPORTATION COMMISSION	
2215 Fairlawn Dr Carthage, MO 64836 417.358.9551 COA# 00062 wearoewn.com	
105 WEST CAPITOL JEFFERSON CITY, MO 65102 1-888-ASK-MODOT (1-888-275-6636)	

IF A SEAL IS PRESENT ON THIS SHEET IT HAS BEEN ELECTRONICALLY SEALED AND DATED.

ALL BEARINGS BASED ON STATE PLANE BEARINGS CENTRAL ZONE.


NE ¼ SW ¼
SEC10-T55N-R20W

30
WILBER DEAN & PAULETTE
FLICKINGER
1500 SF TEMP. ESM'T.
42000.0 SF (0.96 AC) REMAINING

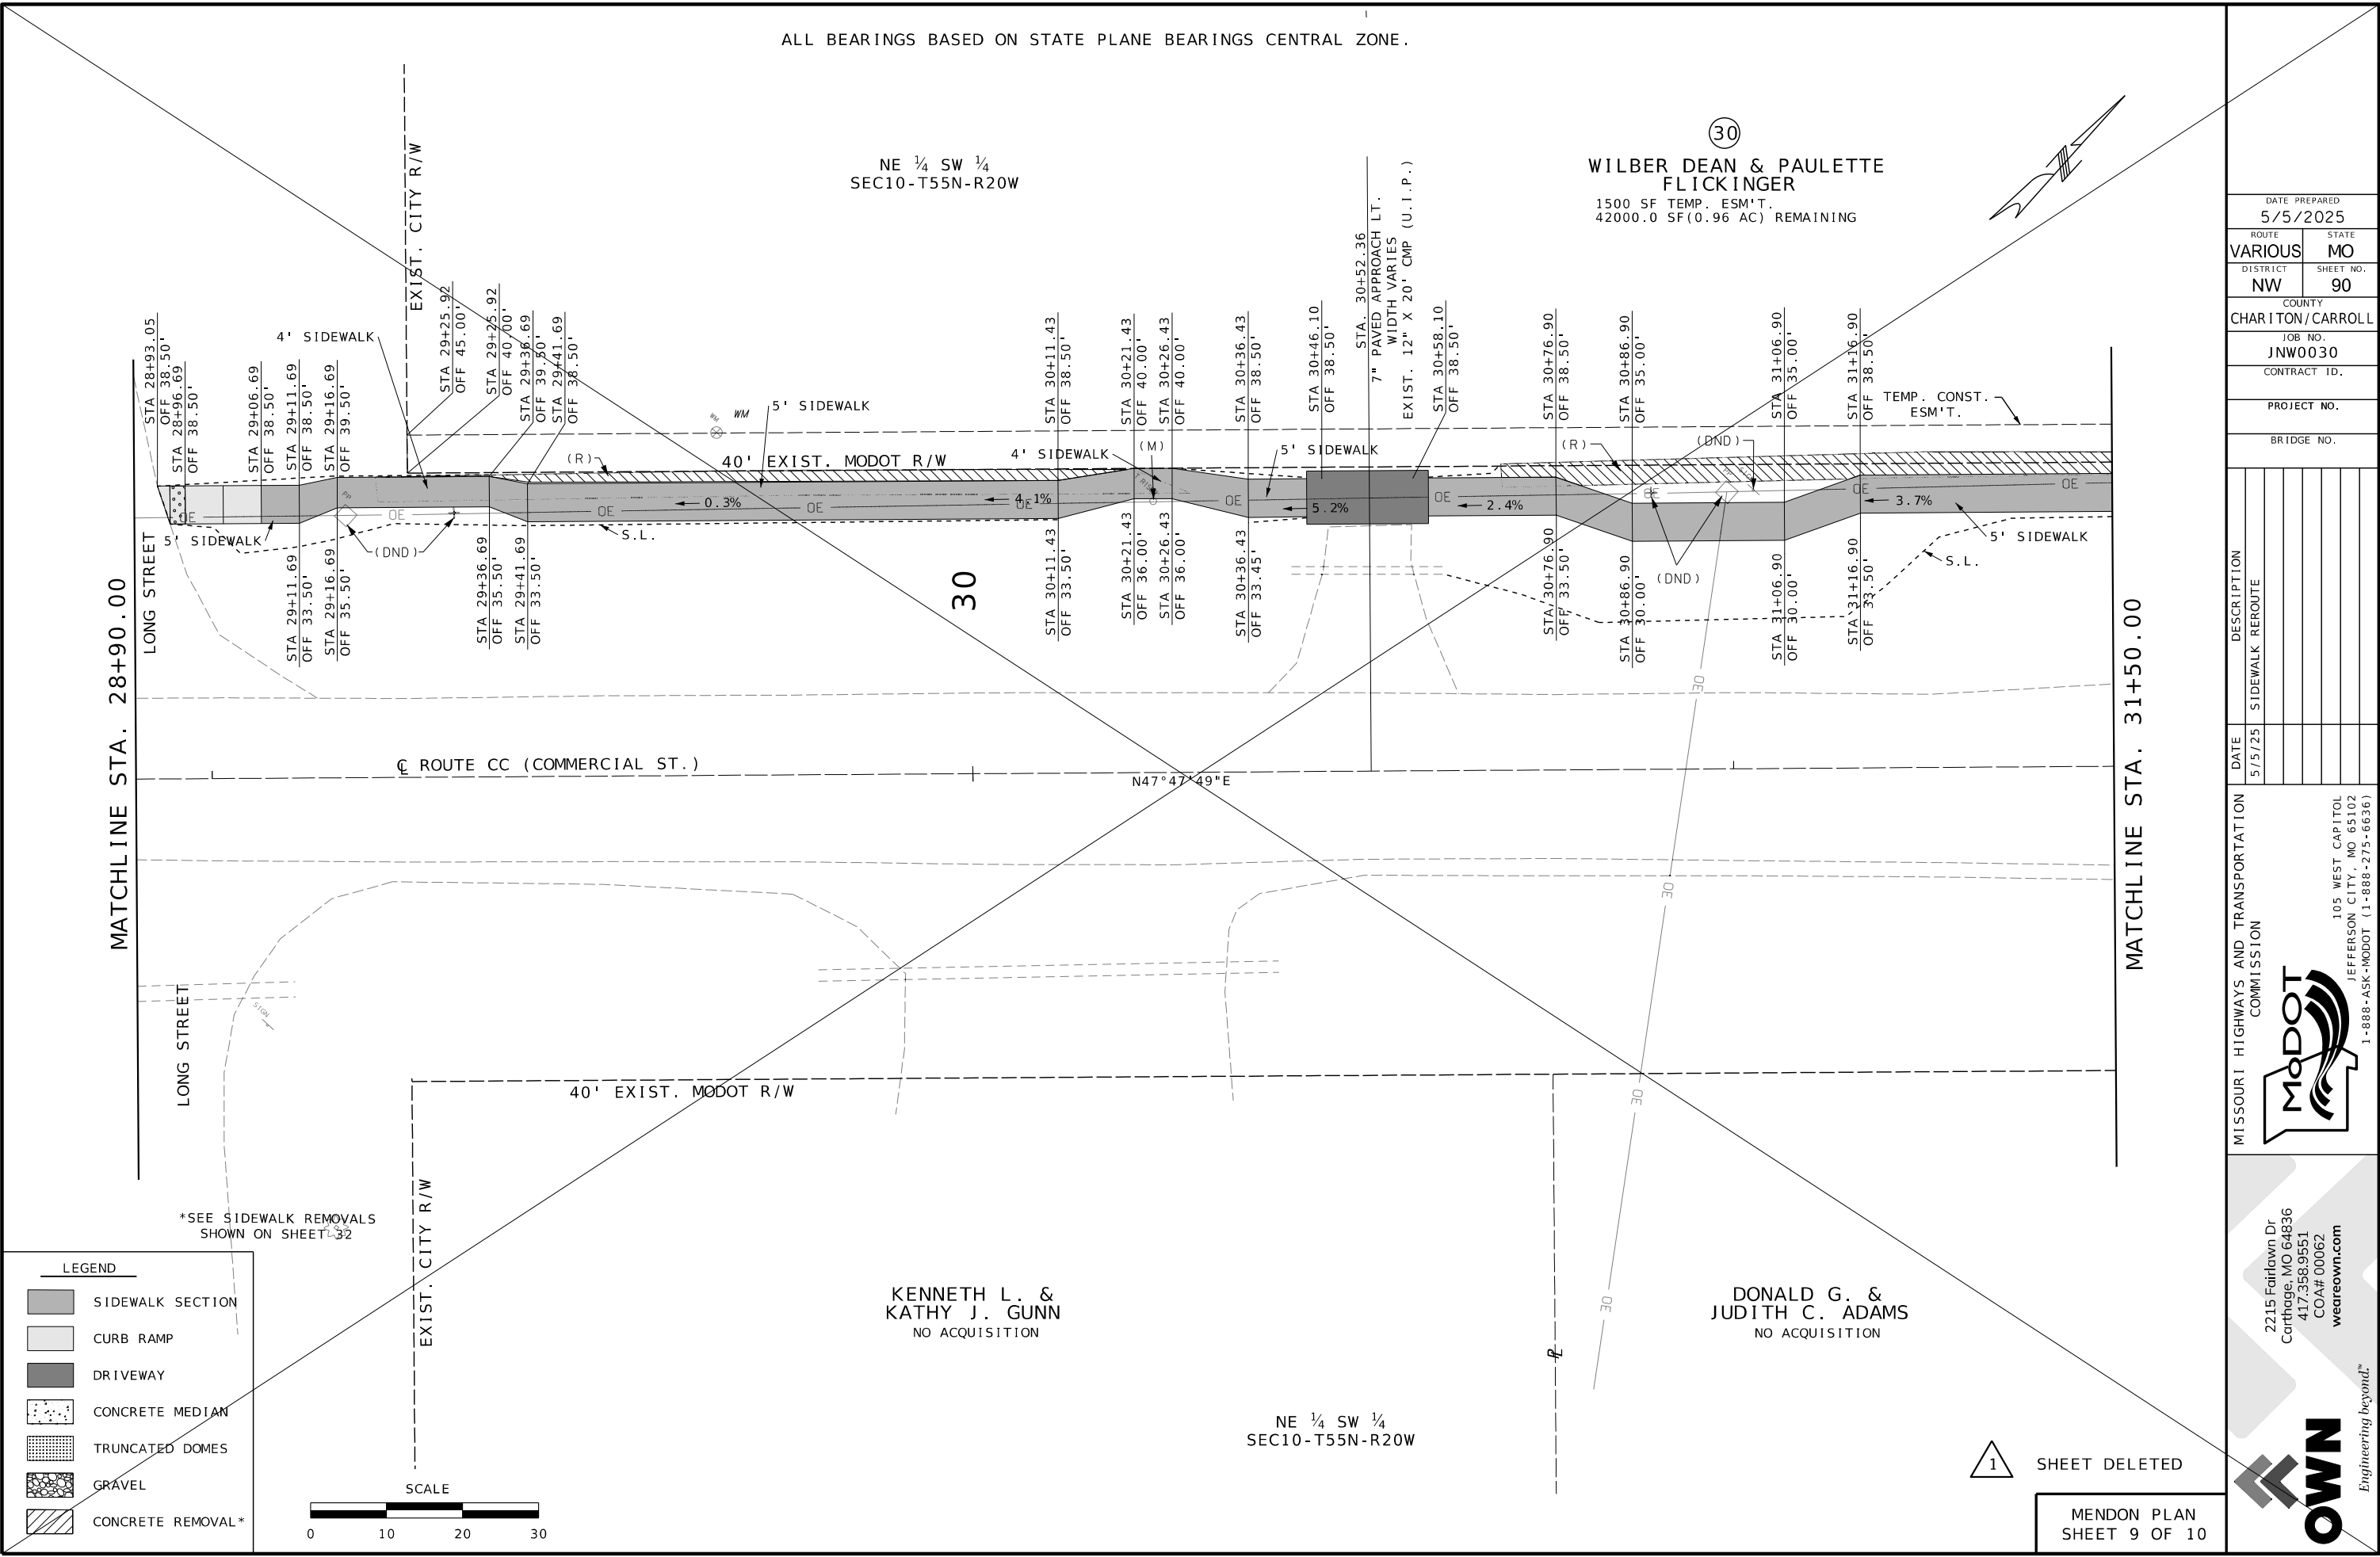

LEGEND

- SIDEWALK SECTION
- CURB RAMP
- DRIVEWAY
- CONCRETE MEDIAN
- TRUNCATED DOMES
- GRAVEL
- CONCRETE REMOVAL*

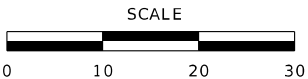

KENNETH L. &
KATHY J. GUNN
NO ACQUISITION

NE ¼ SW ¼
SEC10-T55N-R20W

DONALD G. &
JUDITH C. ADAMS
NO ACQUISITION

1 SHEET DELETED

MENDON PLAN
SHEET 9 OF 10

DATE PREPARED 5/5/2025	
ROUTE VARIOUS	STATE MO
DISTRICT NW	SHEET NO. 90
COUNTY CHARITON / CARROLL	
JOB NO. JNW0030	
CONTRACT ID.	
PROJECT NO.	
BRIDGE NO.	
DATE 5/5/25	DESCRIPTION SIDEWALK REROUTE
MISSOURI HIGHWAYS AND TRANSPORTATION COMMISSION	
2215 Fairlawn Dr Carthage, MO 64836 417.358.9551 COA# 00062 wearemo.com	
105 WEST CAPITAL JEFFERSON CITY, MO 65102 1-888-ASK-MODOT (1-888-275-6636)	
Engineering beyond.	

IF A SEAL IS PRESENT ON THIS SHEET IT HAS BEEN ELECTRONICALLY SEALED AND DATED.

ALL BEARINGS BASED ON STATE PLANE BEARINGS CENTRAL ZONE.

NE ¼ SW ¼
SEC10-T55N-R20W

30
TRAVIS FRYE

1500 SF TEMP. ESM'T.
42000.0 SF(0.96 AC) REMAINING




30' X 18"
W16-7P

18 STA. 29+74.85
19 STA. 29+90.31

MATCHLINE STA. 28+90.00

MATCHLINE STA. 31+50.00

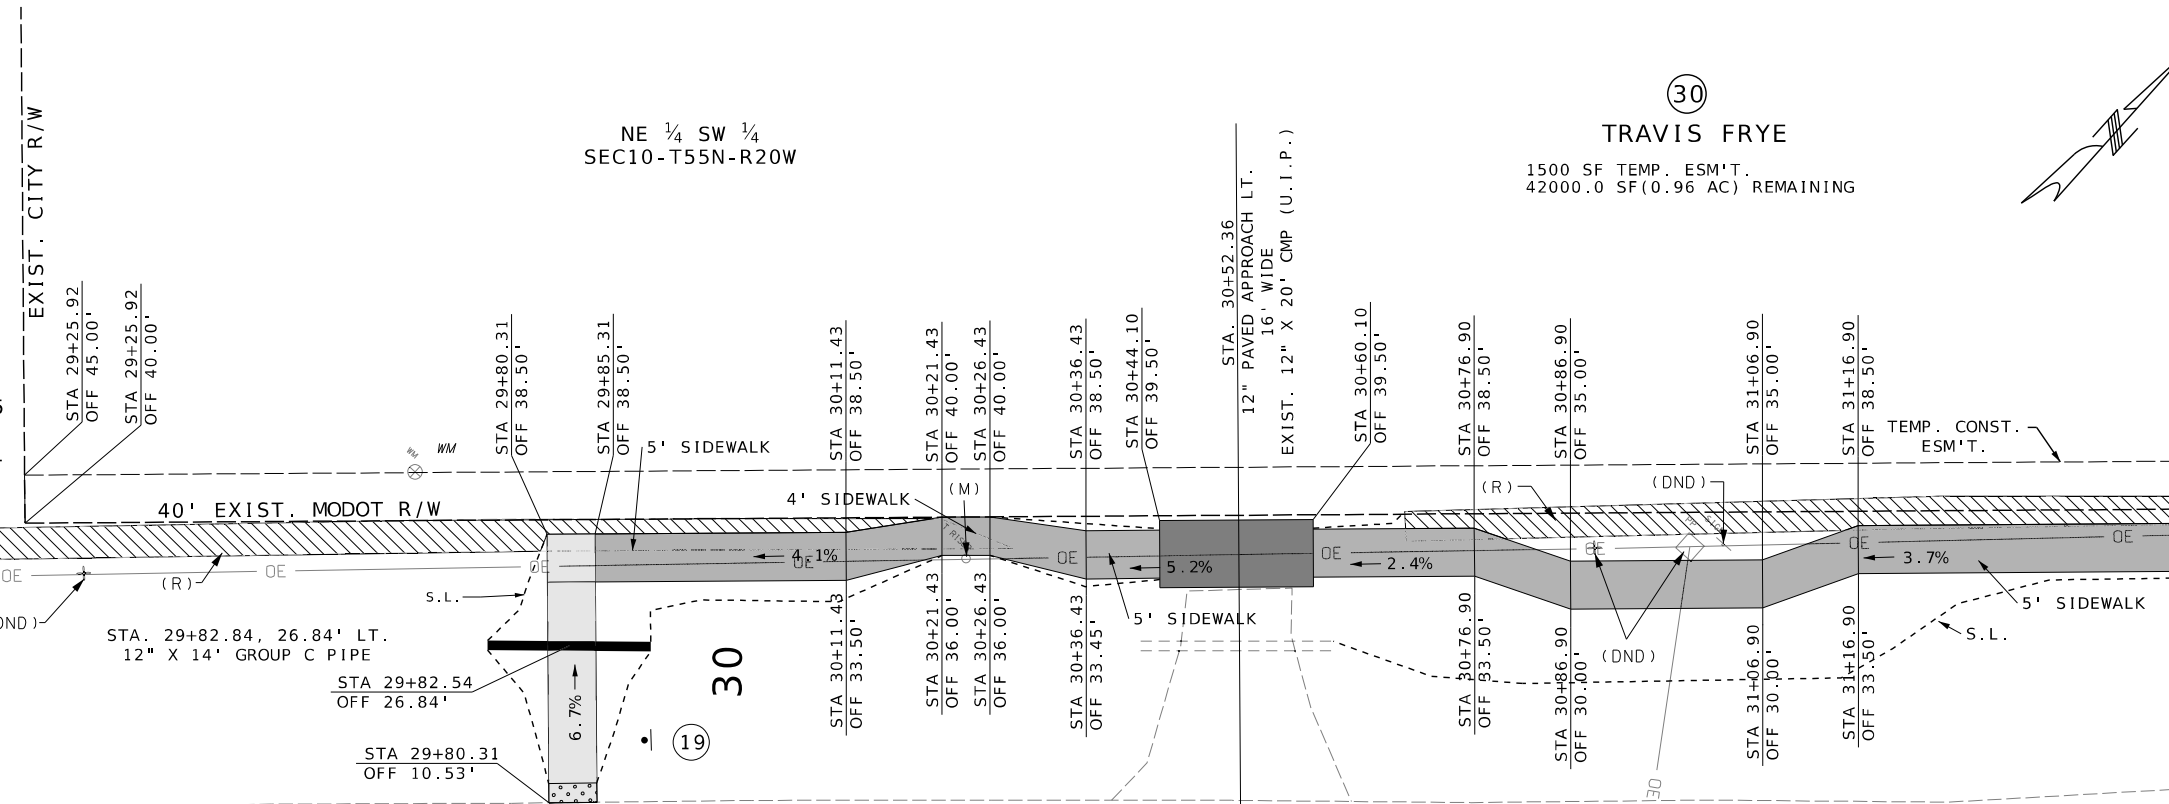

30

19

18

- LEGEND
- SIDEWALK SECTION
 - CURB RAMP
 - DRIVEWAY
 - CONCRETE MEDIAN
 - TRUNCATED DOMES
 - GRAVEL
 - CONCRETE REMOVAL*


KENNETH L. &
KATHY J. GUNN
NO ACQUISITION

DONALD G. &
JUDITH C. ADAMS
NO ACQUISITION

NE ¼ SW ¼
SEC10-T55N-R20W

1 SHEET ADDED

MENDON PLAN
SHEET 9 OF 10

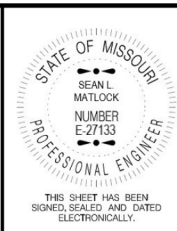

DATE PREPARED
5/5/2025

ROUTE STATE
VARIOUS MO

DISTRICT SHEET NO.
NW 90A

COUNTY
CHARITON / CARROLL

JOB NO.
JNW0030

CONTRACT ID.

PROJECT NO.

BRIDGE NO.

DATE	DESCRIPTION
5/5/25	SIDEWALK REROUTE

MISSOURI HIGHWAYS AND TRANSPORTATION
COMMISSION

MoDOT


105 WEST CAPITOL
JEFFERSON CITY, MO 65102
1-888-ASK-MODOT (1-888-275-6636)

2215 Fairlawn Dr
Carthage, MO 64836
417.358.9551
COA# 00062
weareown.com


OWN
Engineering beyond.

IF A SEAL IS PRESENT ON THIS SHEET IT HAS BEEN ELECTRONICALLY SEALED AND DATED.


ROUTE CC (MAIN ST.)
STA. 24+90.81
EXIST. AGGR. ENTRANCE RT.
14' WIDE
EXIST. 15" X 20' CMP (U.I.P.)

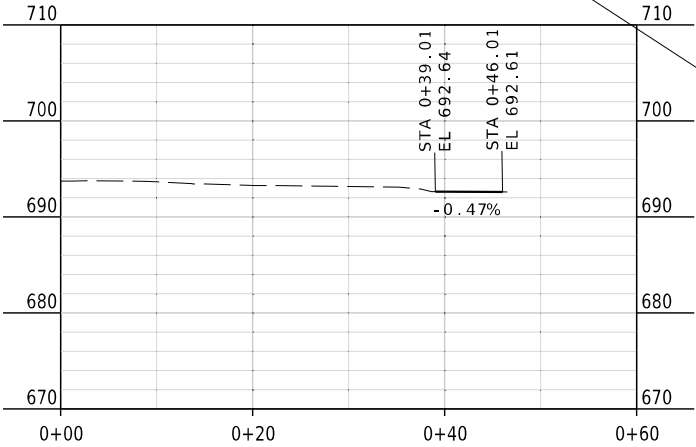


ROUTE CC (COMMERCIAL ST.)
STA. 27+15.96
EXIST. AGGR. ENTRANCE LT.
9.3' WIDE
NO PIPE

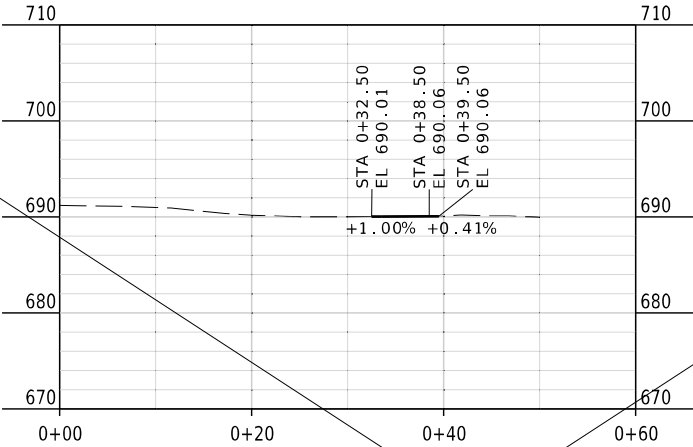

ROUTE CC (COMMERCIAL ST.)
STA. 30+52.36
EXIST. AGGR. ENTRANCE LT.
16' WIDE
EXIST. 12" X 20' CMP (U.I.P.)

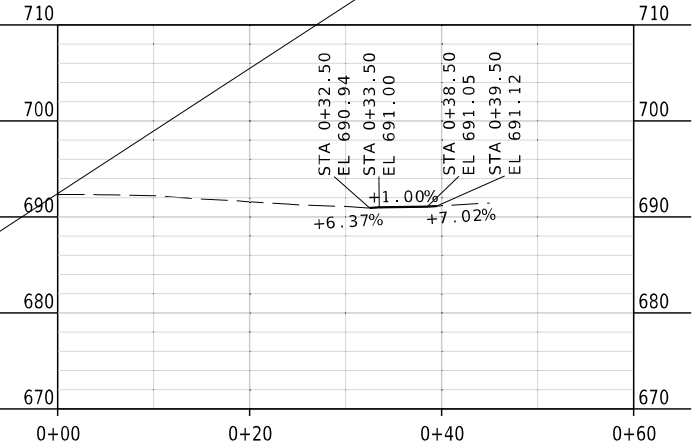

ROUTE CC (COMMERCIAL ST.)
STA. 31+98.21
EXIST. AGGR. ENTRANCE LT.
12' WIDE
EXIST. 12" X 25' CMP (U.I.P.)

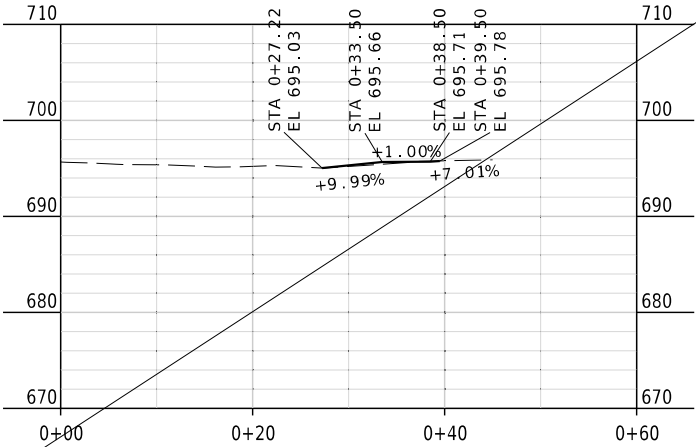

1 SHEET DELETED

DATE PREPARED
5/5/2025

ROUTE
VARIOUS

DISTRICT
NW

COUNTY
CHARITON/CARROLL

JOB NO.
JNW0030

CONTRACT ID.

PROJECT NO.

BRIDGE NO.

DATE
5/5/25

DESCRIPTION
SIDEWALK REROUTE

MISSOURI HIGHWAYS AND TRANSPORTATION COMMISSION



105 WEST CAPITOL
JEFFERSON CITY, MO 65102
1-888-ASK-MODOT (1-888-275-6636)


2215 Fairlawn Dr
Carthage, MO 64836
417.358.9551
COA# 00062
weareown.com




Engineering beyond.

IF A SEAL IS PRESENT ON THIS SHEET IT HAS BEEN ELECTRONICALLY SEALED AND DATED.


ROUTE CC (MAIN ST.)
STA. 24+90.81
EXIST. AGGR. ENTRANCE RT.
14' WIDE
EXIST. 15" X 20' CMP (U.I.P.)

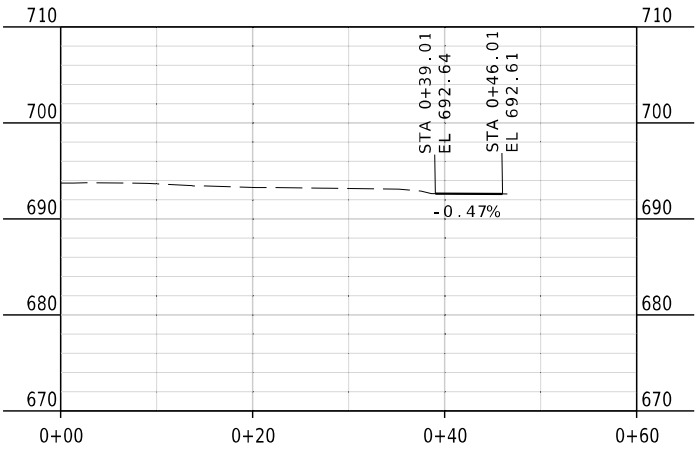


ROUTE CC (COMMERCIAL ST.)
STA. 27+16.01
EXIST. AGGR. ENTRANCE RT.
17' WIDE
18" x 28' PIPE GROUP C

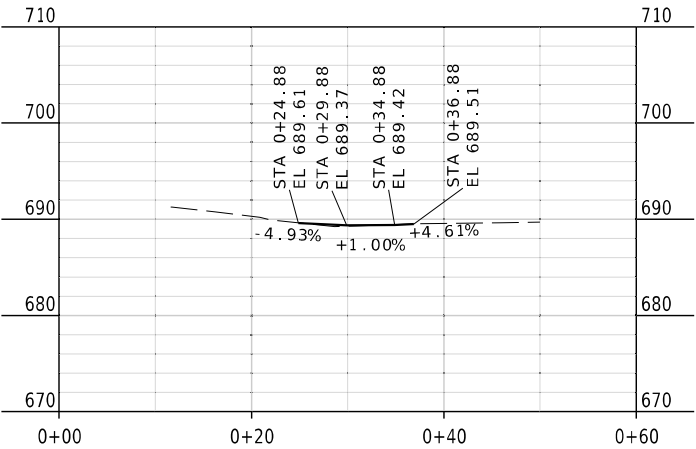


ROUTE CC (COMMERCIAL ST.)
STA. 28+92.24
EXIST. AGGR. ENTRANCE RT.
18.5' WIDE
EXIST. 24" x 36' CMP (U.I.P.)

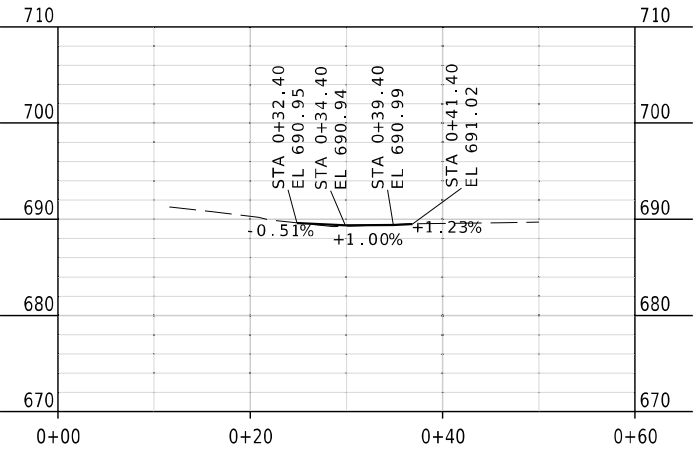

ROUTE CC (COMMERCIAL ST.)
STA. 30+52.36
EXIST. AGGR. ENTRANCE LT.
16' WIDE
EXIST. 12" X 20' CMP (U.I.P.)

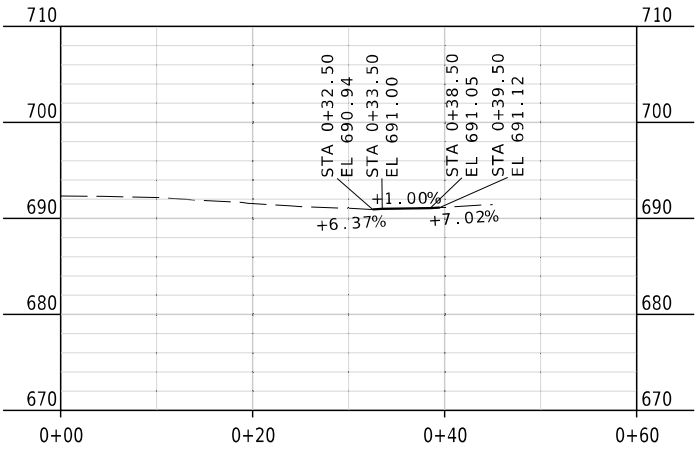

ROUTE CC (COMMERCIAL ST.)
STA. 31+98.21
EXIST. AGGR. ENTRANCE LT.
16' WIDE
EXIST. 12" X 25' CMP (U.I.P.)

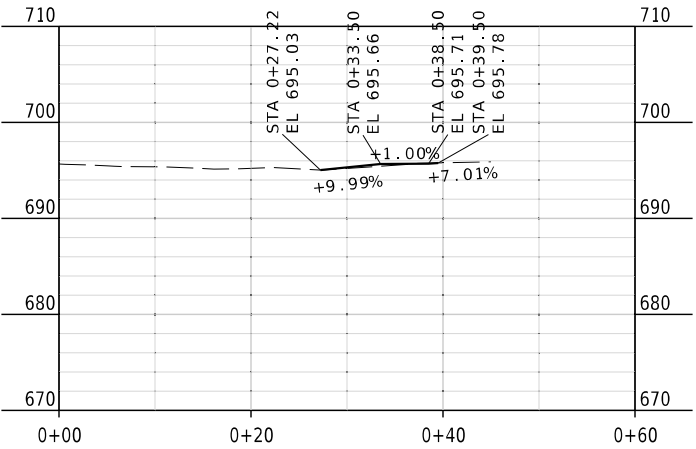

1 SHEET ADDED

STATE OF MISSOURI
SEAN L. MATLOCK
NUMBER E-27133
PROFESSIONAL ENGINEER

THIS SHEET HAS BEEN SIGNED, SEALED AND DATED ELECTRONICALLY.

DATE PREPARED 5/5/2025	
ROUTE VARIOUS	STATE MO
DISTRICT NW	SHEET NO. 130A
COUNTY CHARLTON/CARROLL	
JOB NO. JNW0030	
CONTRACT ID.	
PROJECT NO.	
BRIDGE NO.	
DATE 5/5/25	DESCRIPTION SIDEWALK REROUTE

MISSOURI HIGHWAYS AND TRANSPORTATION COMMISSION

105 WEST CAPITOL
JEFFERSON CITY, MO 65102
1-888-ASK-MODOT (1-888-275-6636)

2215 Fairlawn Dr
Carthage, MO 64836
417.358.9551
COA# 00062
weareown.com

Engineering beyond.

IF A SEAL IS PRESENT ON THIS SHEET IT HAS BEEN ELECTRONICALLY SEALED AND DATED.

SIGNS

902 SIGNAL SIGNS TABULATED ON D-37A SHEET

CONCRETE FOOTINGS EMBEDDED

ITEM NO. 9031010
CY

STRUCTURAL STEEL POSTS*

POST DES NO. POST NO. 1 POST NO. 2 POST NO. 3 LBS PER FT TOTAL 9031210 LBS

PIPE POSTS*

PIPE SIZE POST NO. 1 POST NO. 2 LBS PER FT TOTAL 9031220 LBS

BACKING BARS**

2" X 3/8" BARS AT 2.55 LBS/FT
NO. LGTH TOTAL TOTAL
EACH IN. LF LBS

U-CHANNEL POST

ITEM NO. 9031250A LF

PERFORATED SQUARE STEEL TUBE

2-INCH POST
POST NO. 1 POST NO. 2 TOTAL
ITEM NO. 9031270A
ANCHORS
DRIVEN 12 GA. 7 GA. 7 GA.
ITEM NO. 9031271A 9031273A 9031274
CONCRETE 7 GA. 7 GA.
ITEM NO. 9031280 9031272A 9031281A 9031285
2.5-INCH POST
POST NO. 1 POST NO. 2 TOTAL
ITEM NO. 9031280
2.25" INSERT (6 FT)
ITEM NO. 9031272A 9031281A 9031285
ANCHORS
DRIVEN 7 GA. 7 GA.
ITEM NO. 9031281A 9031285
BREAK-AWAY ASSEMBLY
ITEM NO. 9031241

EFFECTIVE: 07-01-2024

REMARKS AND OTHER REQUIRED ITEMS

SUMNER

1 ASSY 9+02.74 21.29'RT
2 ASSY 9+15.66 24.63'LT
3 ASSY 13+87.65 19.62'LT
4 ASSY 13+98.53 29.94'RT
5 ASSY 16+64.28 37.91'LT
6 ASSY 16+50.86 30.64'RT
7 36" 20+05.61 28.65'LT
7A 36" 16+73.71 53.82'LT

ROTHVILLE

8 ASSY 68+39.49 13.18'RT
9 ASSY 68+57.69 13.24'LT

MENDON

10 ASSY 12+80.35 31.02'RT
11 ASSY 12+97.63 26.53'LT
12 ASSY 16+86.28 38.49'RT
13 ASSY 16+97.59 39.92'LT
14 ASSY 17+43.66 31.42'RT
15 ASSY 17+64.46 29.45'LT
16 ASSY 21+51.88 30.92'RT
17 ASSY 21+54.81 30.14'LT
18 ASSY 25+40.20 13.83'RT
19 ASSY 25+74.34 17.49'LT

NORBORNE

20 ASSY 1212+64.22 13.00'RT
21 ASSY 1212+74.46 16.90'LT
22 36" 1217+85.00 31.54'LT
23 36"X48" 1217+85.00 29.45'RT
24 ASSY 1217+91.81 29.52'RT
25 ASSY 1217+96.29 23.36'LT
26 ASSY 1236+02.71 17.46'RT
27 ASSY 1236+11.02 20.49'LT
28 ASSY 1236+11.47 25.20'LT

BOSWORTH

29 ASSY 443+13.86 15.73'RT
30 ASSY 443+29.34 16.68'LT
31 ASSY 450+85.56 30.31'RT
32 ASSY 600+85.08 25.88'LT
33 ASSY 601+88.66 23.54'RT

SUBTOTAL

TOTAL

**BREAKAWAY ASSEMBLY IS INCIDENTAL FOR STRUCTURAL STEEL AND PIPE POSTS.
**BACKING BARS ARE TOTALED WITH STRUCTURAL STEEL OR PIPE POSTS.

DATE PREPARED
5/5/2025

ROUTE
VARIOUS

DISTRICT
NW

COUNTY
CHARITON/CARROLL

JOB NO.
JNW0030

CONTRACT ID.

PROJECT NO.

BRIDGE NO.

DESCRIPTION
SIDEWALK REROUTE

DATE
5/5/25

MISSOURI HIGHWAYS AND TRANSPORTATION COMMISSION

105 WEST CAPITOL
JEFFERSON CITY, MO 65102
1-888-ASK-MODOT (1-888-275-6636)

2215 Fairlawn Dr
Cathage, MO 64836
417.358.9551
COA# 00062
weareown.com

OWN
Engineering beyond.™

STRUCTURAL STEEL POST AND FOOTING DATA TABLE

POST DES. NO.	NOM. SIZE	POST		STUB LENGTH	DIA.	FOOTING							
		WEIGHT				LEVEL GROUND	6:1 GRADE		4:1 GRADE		3:1 OR 2:1 GRADE		
		LBS/FT	LBS/IN				DEPTH	C.Y.	DEPTH	C.Y.	DEPTH	C.Y.	DEPTH
1	W6	9.0	0.75	3'-0"	15"	3'-0"	0.14	3'-2"	0.15	3'-3"	0.16	3'-6"	0.17
2	W6	15.0	1.25	4'-0"	24"	4'-0"	0.47	4'-2"	0.50	4'-3"	0.51	4'-6"	0.54
3	W8	18.0	1.50	4'-6"	28"	4'-6"	0.71	4'-8"	0.73	4'-9"	0.74	5'-0"	0.78
4	W10	22.0	1.83	5'-0"	36"	5'-0"	1.31	5'-2"	1.36	5'-3"	1.39	5'-6"	1.45
5	W10	26.0	2.17	5'-0"	36"	5'-0"	1.31	5'-3"	1.37	5'-5"	1.43	5'-9"	1.52
6	W12	35.0	2.92	5'-6"	36"	5'-6"	1.44	5'-9"	1.52	5'-11"	1.56	6'-3"	1.65

1

SHEET DELETED

D-29

IF A SEAL IS PRESENT ON THIS SHEET IT HAS BEEN ELECTRONICALLY SEALED AND DATED.

SIGNS

902 SIGNAL SIGNS TABULATED ON D-37A SHEET

CONCRETE FOOTINGS EMBEDDED

ITEM NO. 9031010
CY

STRUCTURAL STEEL POSTS*

POST DES NO. LF NO. 1 LF NO. 2 LF NO. 3 LF LBS PER FT 9031210 LBS

PIPE POSTS*

PIPE SIZE NO. 1 LF NO. 2 LF LBS PER FT 9031220 LBS

BACKING BARS**

2" X 3/8" BARS AT 2.55 LBS/FT
ITEM NO. 9031250A NO. LGTH TOTAL TOTAL EACH IN. LF LBS

U-CHANNEL POST

ITEM NO. 9031250A LF LF LF

PERFORATED SQUARE STEEL TUBE

2-INCH POST

POST NO. 1 LF POST NO. 2 LF TOTAL LF

ANCHORS

DRIVEN 12 GA. 9031271A EACH

DRIVEN 7 GA. 9031273A EACH

CONCRETE 7 GA. 9031274 EACH

2.5-INCH POST

POST NO. 1 LF POST NO. 2 LF TOTAL LF

ANCHORS

2.25" INSERT (6 FT) 9031272A EACH

DRIVEN 7 GA. 9031281A EACH

CONCRETE 7 GA. 9031285 EACH

BREAK-AWAY ASSEMBLY

ITEM NO. 9031241 EACH

EFFECTIVE: 07-01-2024

REMARKS AND OTHER REQUIRED ITEMS

STATE OF MISSOURI
SEAN L. MATLOCK
NUMBER E-27133
PROFESSIONAL ENGINEER
THIS SHEET HAS BEEN SIGNED, SEALED, AND DATED ELECTRONICALLY.

DATE PREPARED
5/5/2025

ROUTE VARIOUS STATE MO
DISTRICT NW SHEET NO. 155A
COUNTY CHARLTON / CARROLL

JOB NO. JNW0030
CONTRACT ID.

PROJECT NO.

BRIDGE NO.

DESCRIPTION
DATE 5/5/25
SIDEWALK REROUTE

MISSOURI HIGHWAYS AND TRANSPORTATION COMMISSION
105 WEST CAPITOL
JEFFERSON CITY, MO 65102
1-888-ASK-MODOT (1-888-273-6636)
2215 Fairlawn Dr
Carthage, MO 64836
417.358.9551
COA# 00062
weareown.com
OWN
Engineering beyond.™

SUMNER

1 ASSY 9+02.74 21.29'RT

2 ASSY 9+15.66 24.63'LT

3 ASSY 13+87.65 19.62'LT

4 ASSY 13+98.53 29.94'RT

5 ASSY 16+64.28 37.91'LT

6 ASSY 16+50.86 30.64'RT

7 36" 20+05.61 28.65'LT

7A 36" 16+73.71 53.82'LT

ROTHVILLE

8 ASSY 68+39.49 13.18'RT

9 ASSY 68+57.69 13.24'LT

MENDON

10 ASSY 12+80.35 31.02'RT

11 ASSY 12+97.63 26.53'LT

12 ASSY 16+86.28 38.49'RT

13 ASSY 16+97.59 39.92'LT

14 ASSY 17+43.66 31.42'RT

15 ASSY 17+64.46 29.45'LT

16 ASSY 21+51.88 30.92'RT

17 ASSY 21+54.81 30.14'LT

18 ASSY 29+74.85 19.37'RT

19 ASSY 29+90.31 16.98'LT

NORBORNE

20 ASSY 1212+64.22 13.00'RT

21 ASSY 1212+74.46 16.90'LT

22 36" 1217+85.00 31.54'LT

23 36"X48" 1217+85.00 29.45'RT

24 ASSY 1217+91.81 29.52'RT

25 ASSY 1217+96.29 23.36'LT

26 ASSY 1236+02.71 17.46'RT

27 ASSY 1236+11.02 20.49'LT

28 ASSY 1236+11.47 25.20'LT

BOSWORTH

29 ASSY 443+13.86 15.73'RT

30 ASSY 443+29.34 16.68'LT

31 ASSY 450+85.56 30.31'RT

32 ASSY 600+85.08 25.88'LT

33 ASSY 601+88.66 23.54'RT

SUBTOTAL

TOTAL

**

48 3 496 31

*BREAKAWAY ASSEMBLY IS INCIDENTAL FOR STRUCTURAL STEEL AND PIPE POSTS.

**BACKING BARS ARE TOTALED WITH STRUCTURAL STEEL OR PIPE POSTS.

STRUCTURAL STEEL POST AND FOOTING DATA TABLE

POST DES. NO.	NOM. SIZE	POST WEIGHT		STUB LENGTH	FOOTING									
		LBS/FT	LBS/IN		DIA.	LEVEL	GROUND	6:1 GRADE		4:1 GRADE		3:1 OR 2:1 GRADE		
					DEPTH	C.Y.	DEPTH	C.Y.	DEPTH	C.Y.	DEPTH	C.Y.	DEPTH	C.Y.
1	W6	9.0	0.75	3'-0"	15"	3'-0"	0.14	3'-2"	0.15	3'-3"	0.16	3'-6"	0.17	
2	W6	15.0	1.25	4'-0"	24"	4'-0"	0.47	4'-2"	0.50	4'-3"	0.51	4'-6"	0.54	
3	W8	18.0	1.50	4'-6"	28"	4'-6"	0.71	4'-8"	0.73	4'-9"	0.74	5'-0"	0.78	
4	W10	22.0	1.83	5'-0"	36"	5'-0"	1.31	5'-2"	1.36	5'-3"	1.39	5'-6"	1.45	
5	W10	26.0	2.17	5'-0"	36"	5'-0"	1.31	5'-3"	1.37	5'-5"	1.43	5'-9"	1.52	
6	W12	35.0	2.92	5'-6"	36"	5'-6"	1.44	5'-9"	1.52	5'-11"	1.56	6'-3"	1.65	

ROUND PIPE POST AND FOOTING DATA TABLE

NOM. SIZE (IN.)	WEIGHT		STUB LENGTH	FOOTING		CONCRETE C.Y.
	LBS/FT	LBS/IN		DIA.	DEPTH	
2½	5.79	0.48	4'- 3/4"	12"	4-6"	0.13
4	10.79	0.90	5'- 3/4"	18"	5-6"	0.36

1

SHEET ADDED

D-29

IF A SEAL IS PRESENT ON THIS SHEET IT HAS BEEN ELECTRONICALLY SEALED AND DATED.

STANDARD SIGN ASSEMBLIES																						
SIGN NO.	STATION OR LOG MILE	LOCATION	SIGN, TYPE, DESIGNATION, SIZE & NUMBER OF EACH																			
			SH	SH	SH	SH																
			 W1x2 36"x36"	 W16-7P 30"x18"	 R1x1 36"	 R2x4 36"x48"																
1	9+02.74	21.29'RT	1	1																		SUMNER
2	9+15.66	24.63'LT	1	1																		SUMNER
3	13+87.65	19.62'LT	1	1																		SUMNER
4	13+98.53	29.94'RT	1	1																		SUMNER
5	16+64.28	37.91'LT	1	1																		SUMNER
6	16+50.86	30.64'RT	1	1																		SUMNER
7A	16+73.71	53.82'LT				1																SUMNER
7	20+05.61	28.65'LT				1																SUMNER
8	68+39.49	13.18'RT	1	1																		ROTHVILLE
9	68+57.69	13.24'LT	1	1																		ROTHVILLE
10	12+80.35	31.02'RT	1	1																		MENDON
11	12+97.63	26.53'LT	1	1																		MENDON
12	16+86.28	38.49'RT	1	1																		MENDON
13	16+97.59	39.92'LT	1	1																		MENDON
14	17+43.66	31.42'RT	1	1																		MENDON
15	17+64.46	29.45'LT	1	1																		MENDON
16	21+51.88	30.92'RT	1	1																		MENDON
17	21+54.81	30.14'LT	1	1																		MENDON
18	25+40.20	13.83'RT	1	1																		MENDON
19	25+74.34	17.49'LT	1	1																		MENDON
20	1212+64.22	13.00'RT	1	1																		NORBORNE
21	1212+74.46	16.90'LT	1	1																		NORBORNE
22	1217+85.00	31.54'LT				1																NORBORNE
23	1217+85.00	29.45'RT					1															NORBORNE
24	1217+91.81	29.52'RT	1	1																		NORBORNE
25	1217+96.29	23.36'LT	1	1																		NORBORNE
26	1236+02.71	17.46'RT	1	1																		NORBORNE
27	1236+11.02	20.49'LT	1	1																		NORBORNE
29	443+13.86	15.73'RT	1	1																		BOSWORTH
30	443+29.34	16.68'LT	1	1																		BOSWORTH
32	600+85.08	25.88 LT	1	1																		BOSWORTH
33	600+88.66	23.54'RT	1	1																		BOSWORTH
TOTALS			28	28	3	1																

SIGN SUMMARY					EFFECTIVE: 10-01-2016			
STANDARD OR SPECIAL SIGN DESIGNATION	SIGN DTL. SHT. NO.	NO. EACH	SIGN SIZE	TYPE & SQUARE FEET				
				FLAT SHEET SH	FLAT SHEET FLUORESCENT SHF*	STRUCTURAL ST	STRUCTURAL FLUORESCENT STF*	
				ITEM NO. 9035004A	ITEM NO. 9035069A	ITEM NO. 9035011A	ITEM NO. 9035071A	
1, 2, 3, 4, 5, 6, 8, 9, 10 11, 12, 13, 14, 15, 16, 17, 18, 19, 20, 21, 24, 25, 26, 27, 29, 30, 32, 33 1, 2, 3, 4, 5, 6, 8, 9, 10 11, 12, 13, 14, 15, 16, 17, 18, 19, 20, 21, 24, 25, 26, 27, 29, 30, 32, 33 7, 7A, 22		28	36"x36"	252				
		28	30"x18"	105				
			36"	22.5				
23			36"x48"	12				

*ORANGE, YELLOW AND YELLOW-GREEN



SHEET DELETED

DATE PREPARED
5/5/2025

ROUTE
VARIOUS

STATE
MO

DISTRICT
NW

SHEET NO.
156

COUNTY
CHARITON / CARROLL

JOB NO.
JNW0030

CONTRACT ID.

PROJECT NO.

BRIDGE NO.

DESCRIPTION

DATE
5/5/25

SIDEWALK

REROUTE

MISSOURI HIGHWAYS AND TRANSPORTATION COMMISSION



2215 Fairlawn Dr
Carthage, MO 64836
417.358.9551
COA# 00062
weareown.com


Engineering beyond.

105 WEST CAPITOL
JEFFERSON CITY, MO 65102
1-888-ASK-MODOT (1-888-273-6636)





IF A SEAL IS PRESENT ON THIS SHEET IT HAS BEEN ELECTRONICALLY SEALED AND DATED.



STANDARD SIGN ASSEMBLIES																					
SIGN NO.	STATION OR LOG MILE	LOCATION	SIGN, TYPE, DESIGNATION, SIZE & NUMBER OF EACH																		
			SH	SH	SH	SH															
			 W11-2 36"x36"	 W10-7P 30"x18"	 R1-1 36"	 R2-1 36"x48"															
1	9+02.74	21.29'RT	1	1															SUMNER		
2	9+15.66	24.63'LT	1	1															SUMNER		
3	13+87.65	19.62'LT	1	1															SUMNER		
4	13+98.53	29.94'RT	1	1															SUMNER		
5	16+64.28	37.91'LT	1	1															SUMNER		
6	16+50.86	30.64'RT	1	1															SUMNER		
7A	16+73.71	53.82'LT			1														SUMNER		
7	20+05.61	28.65'LT			1														SUMNER		
8	68+39.49	13.18'RT	1	1															ROTHVILLE		
9	68+57.69	13.24'LT	1	1															ROTHVILLE		
10	12+80.35	31.02'RT	1	1															MENDON		
11	12+97.63	26.53'LT	1	1															MENDON		
12	16+86.28	38.49'RT	1	1															MENDON		
13	16+97.59	39.92'LT	1	1															MENDON		
14	17+43.66	31.42'RT	1	1															MENDON		
15	17+64.46	29.45'LT	1	1															MENDON		
16	21+51.88	30.92'RT	1	1															MENDON		
17	21+54.81	30.14'LT	1	1															MENDON		
18	29+74.85	19.37'RT	1	1															MENDON		
19	29+90.31	16.98'LT	1	1															MENDON		
20	1212+64.22	13.00'RT	1	1															NORBORNE		
21	1212+74.46	16.90'LT	1	1															NORBORNE		
22	1217+85.00	31.54'LT			1														NORBORNE		
23	1217+85.00	29.45'RT				1													NORBORNE		
24	1217+91.81	29.52'RT	1	1															NORBORNE		
25	1217+96.29	23.36'LT	1	1															NORBORNE		
26	1236+02.71	17.46'RT	1	1															NORBORNE		
27	1236+11.02	20.49'LT	1	1															NORBORNE		
29	443+13.86	15.73'RT	1	1															BOSWORTH		
30	443+29.34	16.68'LT	1	1															BOSWORTH		
32	600+85.08	25.88 LT	1	1															BOSWORTH		
33	600+88.66	23.54'RT	1	1															BOSWORTH		
					</																

[illegible]A triangle with the number 1 inside.

SHEET ADDED

D-30

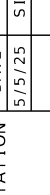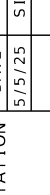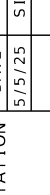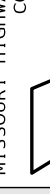 THIS SHEET HAS BEEN SIGNED, SEALED AND DATED ELECTRONICALLY.																													
DATE PREPARED 5/5/2025																													
ROUTE VARIOUS	STATE MO																												
DISTRICT NW	SHEET NO. 156A																												
COUNTY CHARITON/CARROLL																													
JOB NO. JNW0030																													
CONTRACT ID.																													
PROJECT NO.																													
BRIDGE NO.																													
<table border="1" style="width: 100%; border-collapse: collapse;"> <thead> <tr> <th style="width: 15%;">DATE</th> <th style="width: 30%;">DESCRIPTION</th> </tr> </thead> <tbody> <tr><td>5/5/25</td><td>SIDEWALK REROUTE</td></tr> <tr><td> </td><td> </td></tr> <tr><td> </td><td> </td></tr> <tr><td> </td><td> </td></tr> <tr><td> </td><td> </td></tr> <tr><td> </td><td> </td></tr> <tr><td> </td><td> </td></tr> <tr><td> </td><td> </td></tr> <tr><td> </td><td> </td></tr> <tr><td> </td><td> </td></tr> </tbody> </table> <table border="1" style="width: 100%; border-collapse: collapse;"> <tr> <td colspan="2" style="text-align: center;"> MISSOURI HIGHWAYS AND TRANSPORTATION COMMISSION </td> </tr> <tr> <td colspan="2" style="text-align: center;">  </td> </tr> <tr> <td colspan="2" style="text-align: center;"> 105 WEST CAPITAL JEFFERSON CITY, MO 65102 1-888-ASK-MODOT (1-888-275-6636) </td> </tr> </table>		DATE	DESCRIPTION	5/5/25	SIDEWALK REROUTE																			MISSOURI HIGHWAYS AND TRANSPORTATION COMMISSION				105 WEST CAPITAL JEFFERSON CITY, MO 65102 1-888-ASK-MODOT (1-888-275-6636)	
DATE	DESCRIPTION																												
5/5/25	SIDEWALK REROUTE																												
MISSOURI HIGHWAYS AND TRANSPORTATION COMMISSION																													
																													
105 WEST CAPITAL JEFFERSON CITY, MO 65102 1-888-ASK-MODOT (1-888-275-6636)																													
2215 Fairlawn Dr Carthage, MO 64836 417.358.9551 COA# 00062  OWN Engineering beyond.™																													

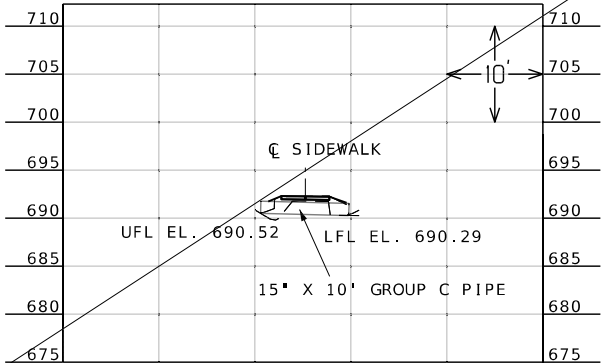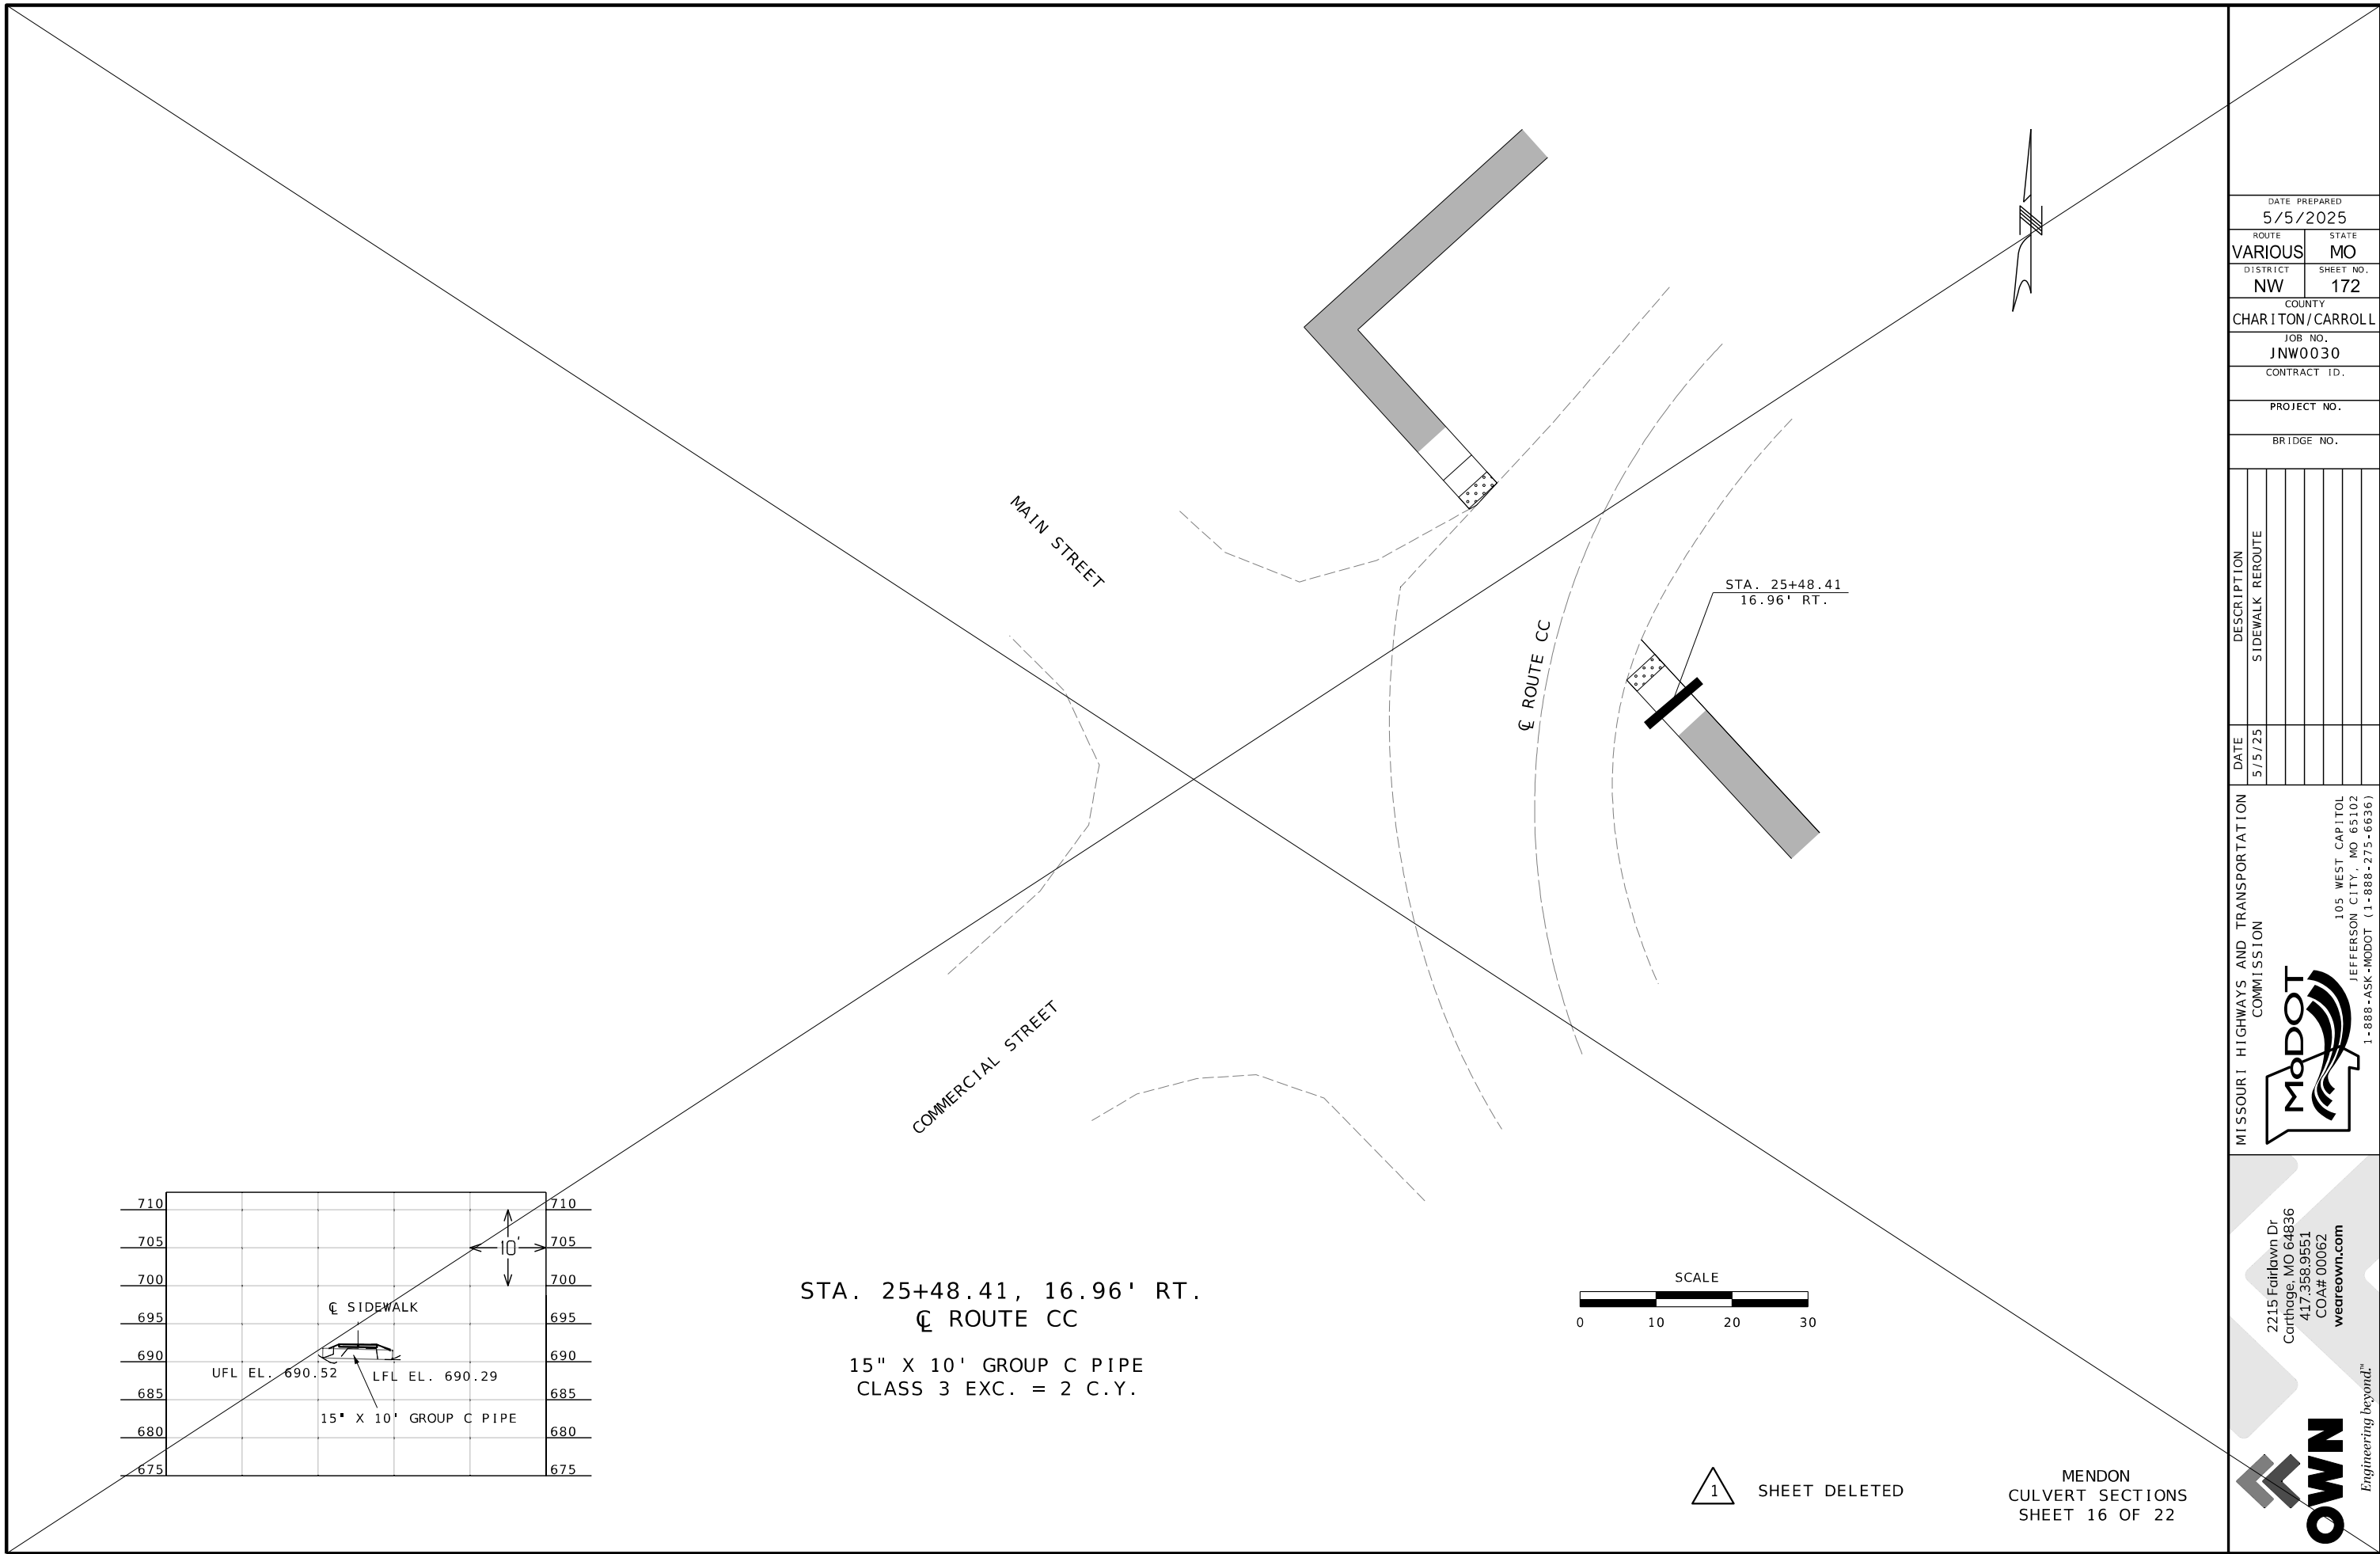

STA. 25+48.41, 16.96' RT.
☐ ROUTE CC

15" X 10' GROUP C PIPE
CLASS 3 EXC. = 2 C.Y.



SHEET DELETED

MENDON
CULVERT SECTIONS
SHEET 16 OF 22

DATE PREPARED 5/5/2025	
ROUTE VARIOUS	STATE MO
DISTRICT NW	SHEET NO. 172
COUNTY CHARLTON / CARROLL	
JOB NO. JNW0030	
CONTRACT ID.	
PROJECT NO.	
BRIDGE NO.	

DATE	DESCRIPTION
5/5/25	SIDEWALK REROUTE


MISSOURI HIGHWAYS AND TRANSPORTATION
COMMISSION

105 WEST CAPITOL
JEFFERSON CITY, MO 65102
1-888-ASK-MODOT (1-888-275-6636)


2215 Fairlawn Dr
Carthage, MO 64836
417.358.9551
COA# 00062
weareown.com

Engineering beyond.™


IF A SEAL IS PRESENT ON THIS SHEET IT HAS BEEN ELECTRONICALLY SEALED AND DATED.

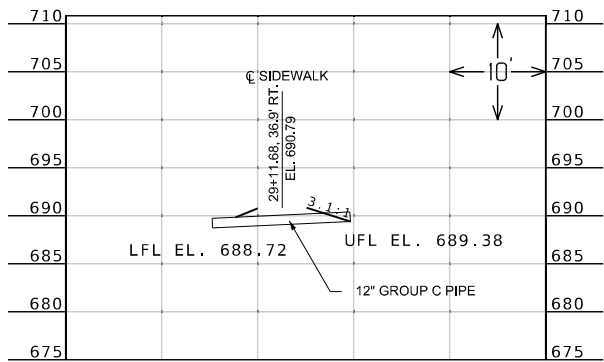


STA. 29+11.68, 36.90' RT.
CL ROUTE CC
12" X 15'
GROUP C PIPE
CLASS 3 EXC. = 1 C.Y.

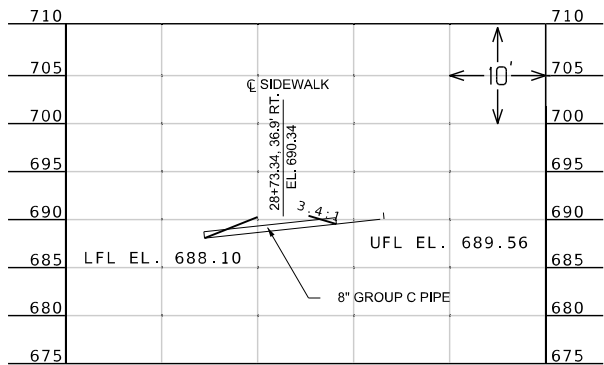


STA. 28+73.34, 36.90' RT.
CL ROUTE CC
8" X 14'
GROUP C PIPE
CLASS 3 EXC. = 1 C.Y.

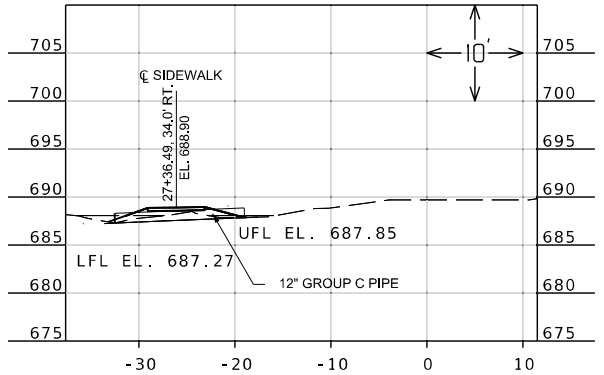


STA. 27+36.49, 34.00' RT.
CL ROUTE CC
12" X 14'
GROUP C PIPE
CLASS 3 EXC. = 1 C.Y.

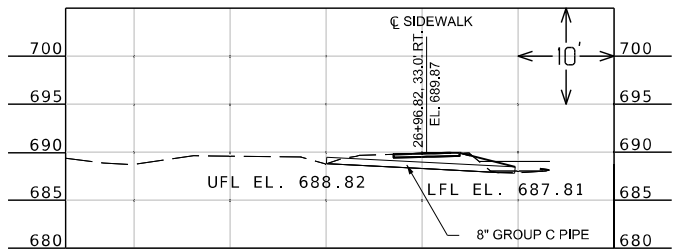

STA. 26+96.82, 33.00' RT.
CL ROUTE CC
8" X 20'
GROUP C PIPE
CLASS 3 EXC. = 3 C.Y.

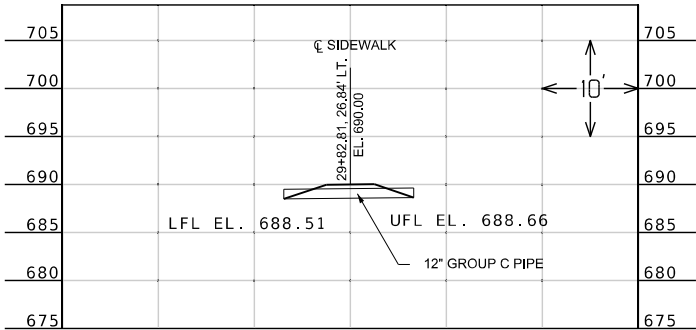

STA. 29+82.81, 26.84' LT.
CL ROUTE CC
12" X 14'
GROUP C PIPE
CLASS 3 EXC. = 1 C.Y.

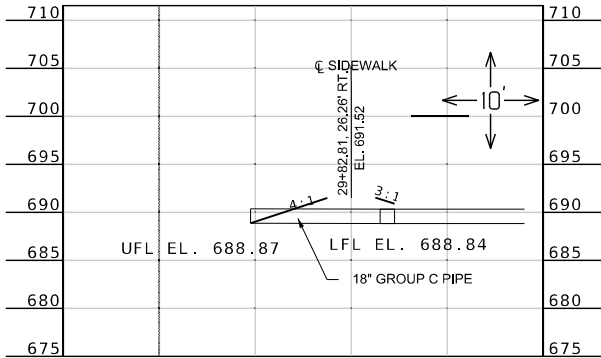

STA. 29+82.81, 26.26' RT.
CL ROUTE CC
EXIST. 18" X 60' CMP
EXTEND 18" X 15'
GROUP C PIPE
CLASS 3 EXC. = 2 C.Y.

STA 0+10.64

1 SHEET ADDED

DATE PREPARED
5/5/2025

ROUTE
VARIOUS

DISTRICT
NW

COUNTY
CHARLTON / CARROLL

JOB NO.
JNW0030

CONTRACT ID.

PROJECT NO.

BRIDGE NO.

STATE
MO

SHEET NO.
172A

DESCRIPTION
SIDEWALK REROUTE

DATE
5/5/25



MISSOURI HIGHWAYS AND TRANSPORTATION COMMISSION

105 WEST CAPITOL
JEFFERSON CITY, MO 65102
1-888-ASK-MODOT (1-888-275-6636)

2215 Fairlawn Dr
Carthage, MO 64836
417.358.9551
COA# 00062
weareown.com

Engineering beyond.

IF A SEAL IS PRESENT ON THIS SHEET IT HAS BEEN ELECTRONICALLY SEALED AND DATED.

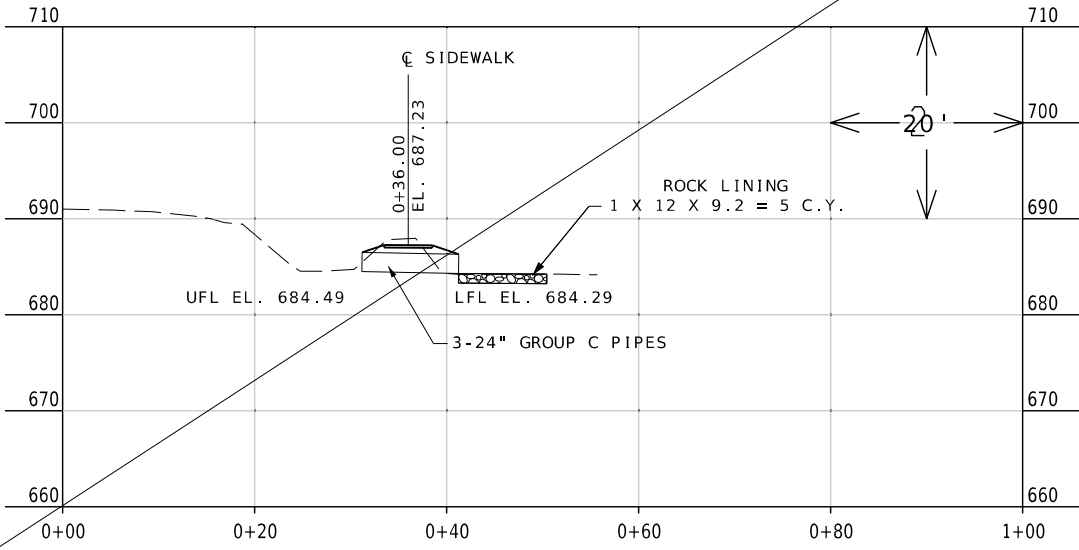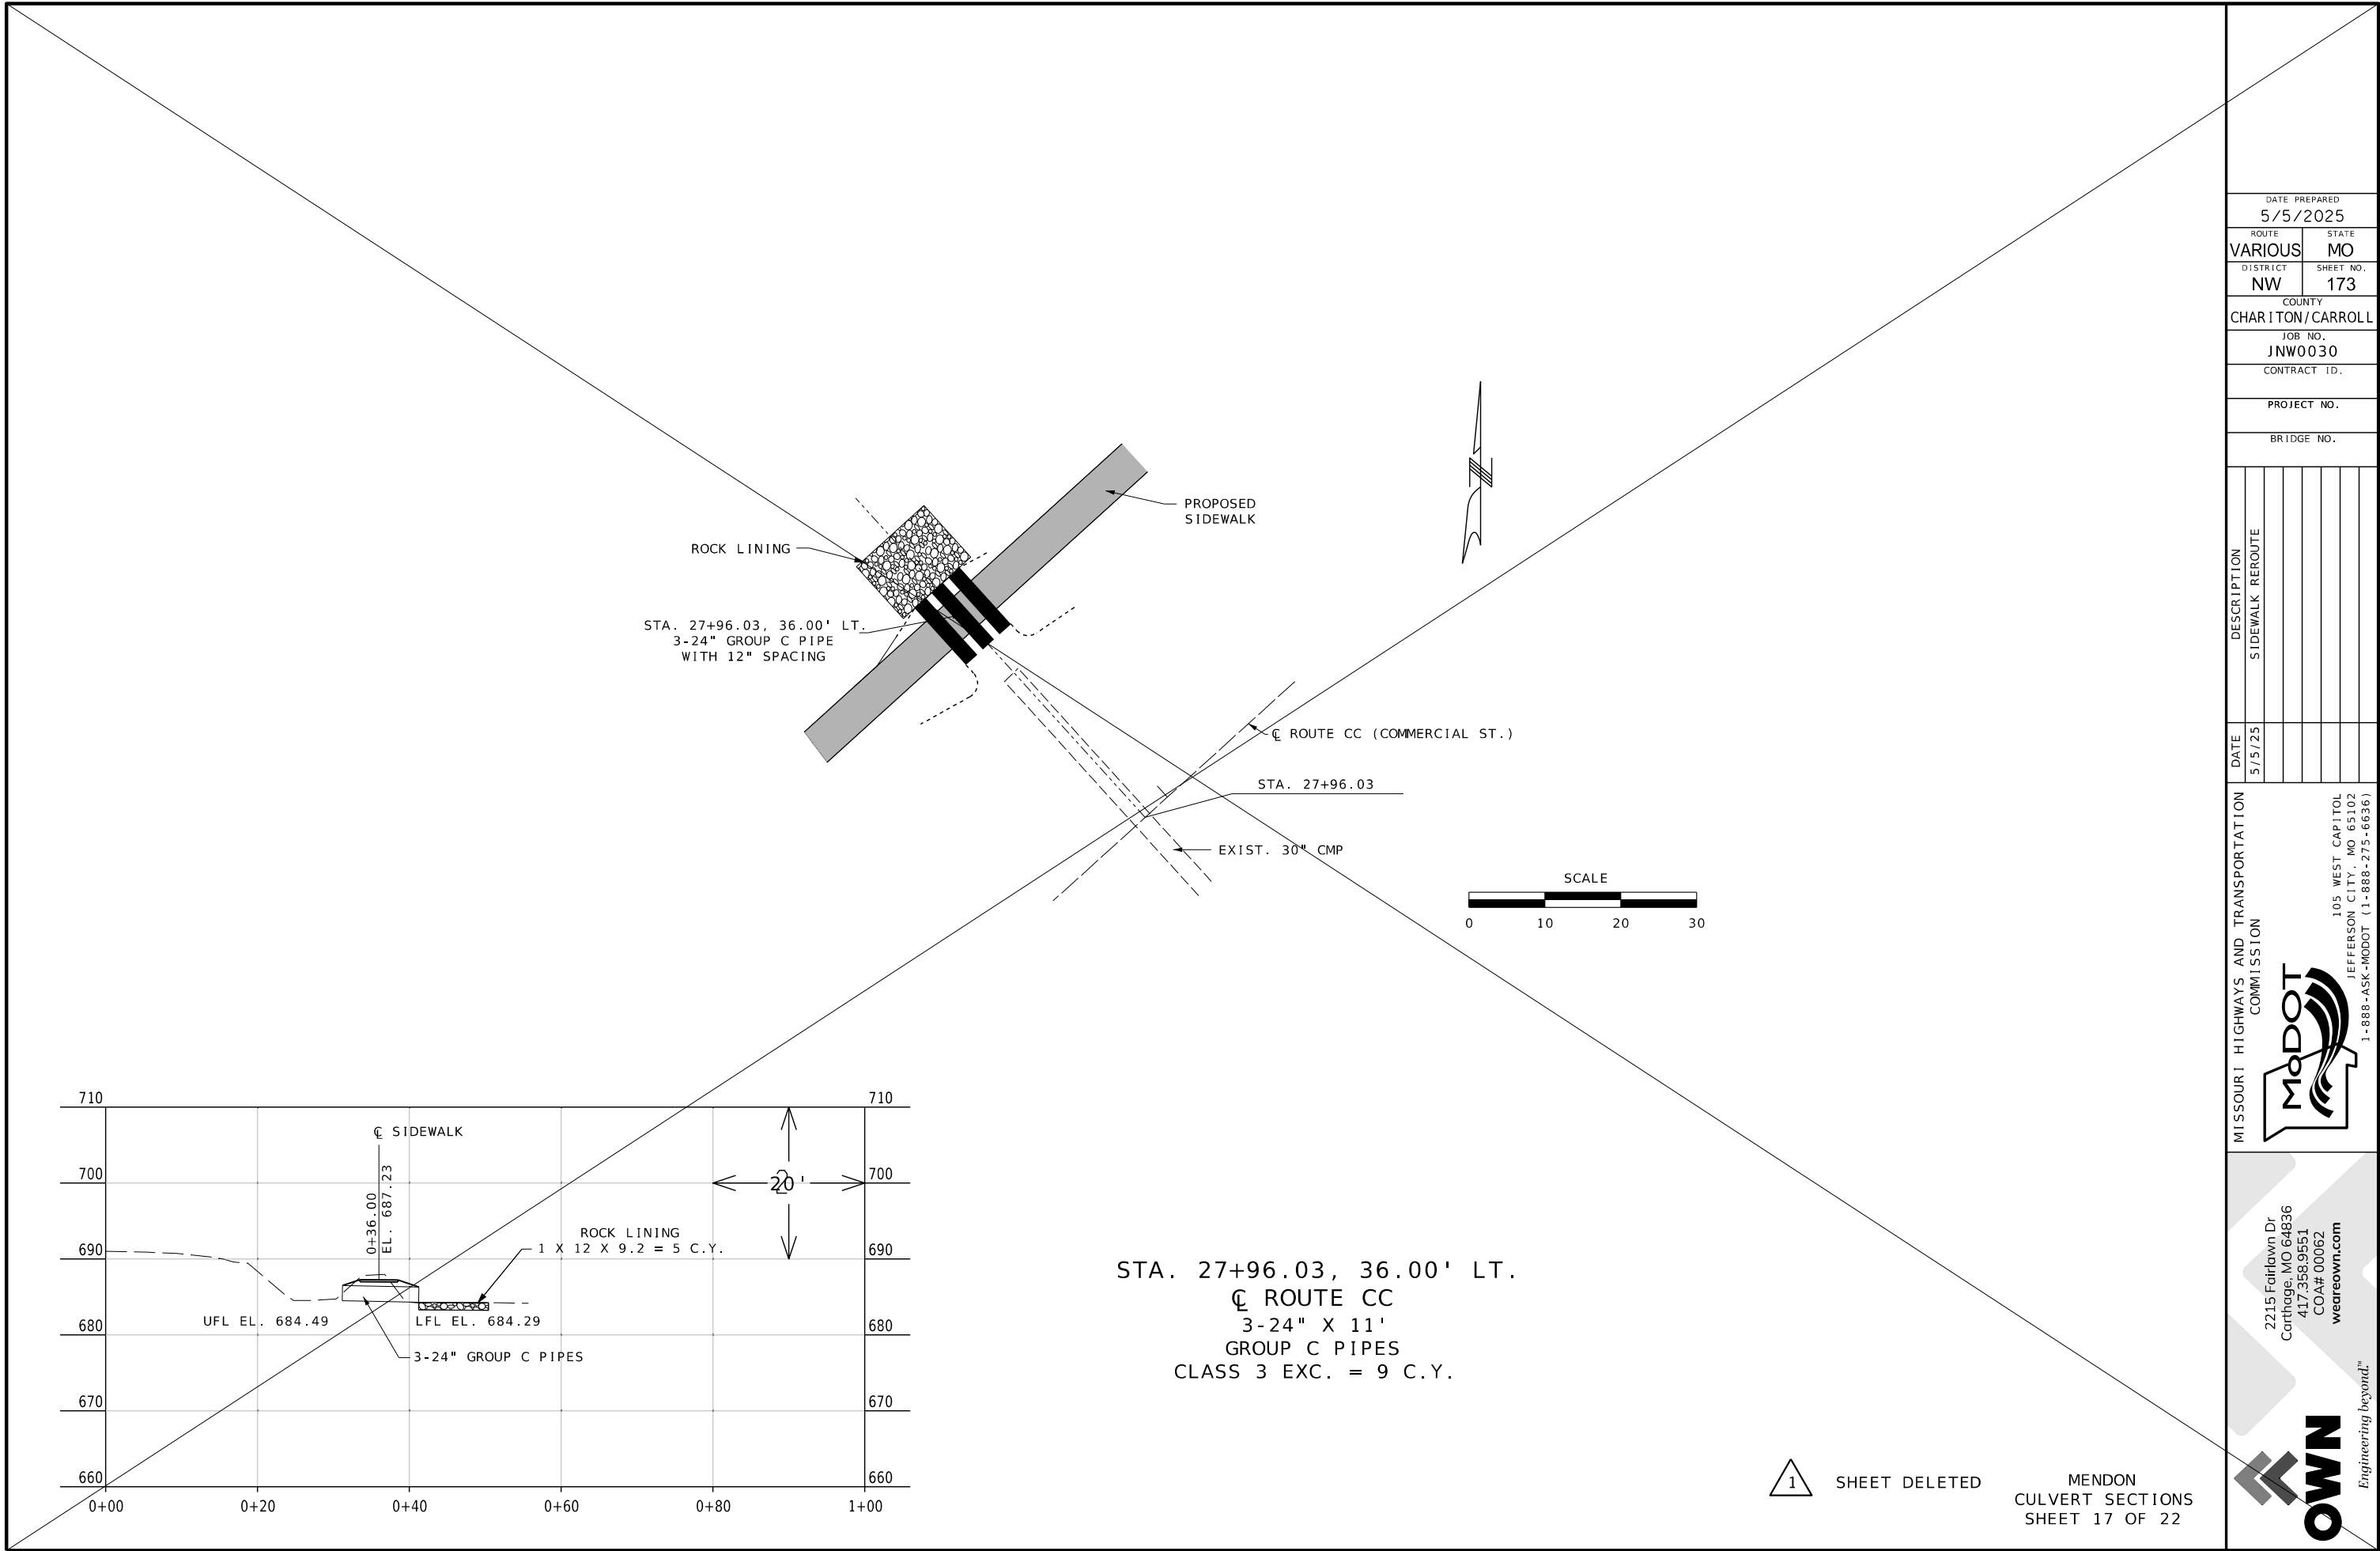

STA. 27+96.03, 36.00' LT.
CL ROUTE CC
3-24" X 11'
GROUP C PIPES
CLASS 3 EXC. = 9 C.Y.

1 SHEET DELETED

MENDON
CULVERT SECTIONS
SHEET 17 OF 22

DATE PREPARED 5/5/2025	
ROUTE VARIOUS	STATE MO
DISTRICT NW	SHEET NO. 173
COUNTY CHARITON/CARROLL	
JOB NO. JNW0030	
CONTRACT ID.	
PROJECT NO.	
BRIDGE NO.	
DESCRIPTION SIDEWALK REROUTE	DATE 5/5/25

MISSOURI HIGHWAYS AND TRANSPORTATION COMMISSION

MoDOT

105 WEST CAPITOL
JEFFERSON CITY, MO 65102
1-888-ASK-MODOT (1-888-275-6636)

2215 Fairlawn Dr
Carthage, MO 64836
417.358.9551
COA# 00062
weareown.com

OWN
Engineering beyond.

IF A SEAL IS PRESENT ON THIS SHEET IT HAS BEEN ELECTRONICALLY SEALED AND DATED.