

REMOVAL FOR FULL DEPTH REPAIRS,
UNBONDED CONCRETE OVERLAY

1 REVISED PAVEMENT REPAIR SOUTH BOUND SHEET 1

LOG MILE		LOCATION	WIDTH	LENGTH	1	FULL DEPTH REPAIRS OF UNBONDED CONCRETE OVERLAY						
					REVIS REMOVAL FOR PARTIAL DEPTH PAVEMENT REPAIR S.Y.	FURNISHING AND PLACING CONCRETE MATERIAL C.Y.	UNBONDED CONCRETE OVERLAY INTERLAYER S.Y.	SAW CUTS INTERNAL AND PERIMETER L.F.	DOWEL BAR (DRILLING, FURNISHING, AND INSTALLATION EACH	DOWEL BAR (FURNISHING AND INSTALLATION WITH BASKETS) EACH	TIE BAR (DRILLING, FURNISHING AND INSTALLATION) EACH	PORTLAND CEMENT CONCRETE SHOULDER RUMBLE STRIP STA.
FROM	TO											
66.139	66.140	DRIVING LANE	14	6	9.33	2.85	9.33	40	20			
66.152	66.153	DRIVING LANE	14	6	9.33	2.85	9.33	40	20			
66.171	66.172	DRIVING LANE	14	6	9.33	2.85	9.33	40	20			
66.267	66.268	DRIVING LANE	14	6	9.33	2.85	9.33	40	20			
66.275	66.277	DRIVING LANE	14	8	12.44	3.80	12.44	44	20			
66.298	66.299	DRIVING LANE	14	6	9.33	2.85	9.33	40	20			
66.346	66.363	DRIVING LANE	14	90	140.00	42.78	140.00	280	20	60	36	0.9
66.364	66.365	DRIVING LANE	14	6	9.33	2.85	9.33	40	20			
66.376	66.377	DRIVING LANE	14	6	9.33	2.85	9.33	40	20			
66.377	66.378	DRIVING LANE	14	6	9.33	2.85	9.33	40	20			
66.380	66.381	DRIVING LANE	14	6	9.33	2.85	9.33	40	20			
66.382	66.383	DRIVING LANE	14	6	9.33	2.85	9.33	40	20			
66.386	66.387	DRIVING LANE	14	6	9.33	2.85	9.33	40	20			
66.389	66.390	DRIVING LANE	14	6	9.33	2.85	9.33	40	20			
66.392	66.393	DRIVING LANE	14	6	9.33	2.85	9.33	40	20			
66.395	66.396	DRIVING LANE	14	6	9.33	2.85	9.33	40	20			
66.398	66.399	DRIVING LANE	14	6	9.33	2.85	9.33	40	20			
66.401	66.402	DRIVING LANE	14	6	9.33	2.85	9.33	40	20			
66.404	66.405	DRIVING LANE	14	6	9.33	2.85	9.33	40	20			
66.406	66.407	DRIVING LANE	14	6	9.33	2.85	9.33	40	20			
66.412	66.413	DRIVING LANE	14	6	9.33	2.85	9.33	40	20			
66.421	66.422	DRIVING LANE	14	6	9.33	2.85	9.33	40	20			
66.424	66.425	DRIVING LANE	14	6	9.33	2.85	9.33	40	20			
66.430	66.431	DRIVING LANE	14	6	9.33	2.85	9.33	40	20			
66.431	66.434	DRIVING LANE	14	15	23.33	7.13	23.33	58	20			0.15
66.447	66.449	DRIVING LANE	14	8	12.44	3.80	12.44	44	20			
66.527	66.531	DRIVING LANE	14	20	31.11	9.51	31.11	68	20			0.2
66.540	66.546	DRIVING LANE	14	30	46.67	14.26	46.67	112	20	20	12	0.3
66.548	66.549	DRIVING LANE	14	6	9.33	2.85	9.33	40	20			
66.551	66.552	DRIVING LANE	14	6	9.33	2.85	9.33	40	20			
66.554	66.555	DRIVING LANE	14	6	9.33	2.85	9.33	40	20			
66.557	66.558	DRIVING LANE	14	6	9.33	2.85	9.33	40	20			
66.564	66.565	DRIVING LANE	14	6	9.33	2.85	9.33	40	20			
66.568	66.569	DRIVING LANE	14	6	9.33	2.85	9.33	40	20			
66.570	66.571	DRIVING LANE	14	6	9.33	2.85	9.33	40	20			
66.575	66.576	DRIVING LANE	14	6	9.33	2.85	9.33	40	20			
66.578	66.579	DRIVING LANE	14	6								

SUMMARY OF QUANTITIES
SHEET 1 OF 19



THIS SHEET HAS BEEN
SIGNED, SEALED AND DATED
ELECTRONICALLY.

DATE PREPARED
4/10/2024

ROUTE I - 35	STATE MO
-----------------	-------------

DISTRICT	SHEET NO.
NW	3

COUNTY
CLINTON

JOB NO.
JNW0129

CONTRACT ID.

PROJECT NO.

BRIDGE NO. _____

[illegible]

MISSOURI HIGHWAYS AND TRANSPORTATION
COMMISSION

The logo for the Missouri Department of Transportation (MoDOT) features the word "MoDOT" in a stylized, bold, sans-serif font. The letters are white and set against a dark blue background. Below the text, there are three curved, horizontal lines in a lighter shade of blue, suggesting a road or a bridge. The entire logo is enclosed within a white rectangular border.


105 WEST CAPITOL
JEFFERSON CITY, MO 65102
1-888-ASK-MODOT (1-888-275-6636)

REMOVAL FOR FULL DEPTH REPAIRS,
UNBONDED CONCRETE OVERLAY

1 REVISED PAVEMENT REPAIR SOUTH BOUND SHEET 2

LOG MILE		LOCATION	WIDTH	LENGTH	1	PARTIAL DEPTH PAVEMENT REPAIR		FULL DEPTH REPAIRS OF UNBONDED CONCRETE OVERLAY					
						REVISED REMOVAL FOR PARTIAL DEPTH PAVEMENT REPAIR	FURNISHING AND PLACING CONCRETE MATERIAL	UNBONDED CONCRETE OVERLAY INTERLAYER	SAW CUTS INTERNAL AND PERIMETER	DOWEL BAR (DRILLING, FURNISHING, AND INSTALLATION EACH	DOWEL BAR (FURNISHING AND INSTALLATION WITH BASKETS) EACH	TIE BAR (DRILLING, FURNISHING AND INSTALLATION) EACH	PORTLAND CEMENT CONCRETE SHOULDER RUMBLE STRIP STA.
FROM	TO					S.Y.	C.Y.	S.Y.	L.F.				
66.802	66.803	DRIVING LANE	14	6		9.33	2.85	9.33	40	20			
66.814	66.815	DRIVING LANE	14	6		9.33	2.85	9.33	40	20			
66.875	66.876	DRIVING LANE	14	6		9.33	2.85	9.33	40	20			
66.967	66.968	DRIVING LANE	14	6		9.33	2.85	9.33	40	20			
66.987	66.988	DRIVING LANE	14	6		9.33	2.85	9.33	40	20			
67.030	67.033	DRIVING LANE	14	18		28.00	8.56	28.00	64	20			0.18
67.110	67.111	DRIVING LANE	14	6		9.33	2.85	9.33	40	20			
67.117	67.118	DRIVING LANE	14	6		9.33	2.85	9.33	40	20			
67.129	67.132	DRIVING LANE	14	18		28.00	8.56	28.00	64	20			0.18
67.149	67.150	DRIVING LANE	14	6		9.33	2.85	9.33	40	20			
67.166	67.167	DRIVING LANE	14	6		9.33	2.85	9.33	40	20			
67.234	67.235	DRIVING LANE	14	6		9.33	2.85	9.33	40	20			
67.240	67.241	DRIVING LANE	14	6		9.33	2.85	9.33	40	20			
67.246	67.247	DRIVING LANE	14	6		9.33	2.85	9.33	40	20			
67.251	67.252	DRIVING LANE	14	6		9.33	2.85	9.33	40	20			
67.254	67.255	DRIVING LANE	14	6		9.33	2.85	9.33	40	20			
67.260	67.261	DRIVING LANE	14	6		9.33	2.85	9.33	40	20			
67.262	67.263	DRIVING LANE	14	6		9.33	2.85	9.33	40	20			
67.271	67.272	DRIVING LANE	14	6		9.33	2.85	9.33	40	20			
67.276	67.277	DRIVING LANE	14	6		9.33	2.85	9.33	40	20			
67.297	67.298	DRIVING LANE	14	6		9.33	2.85	9.33	40	20			
67.365	67.366	DRIVING LANE	14	6		9.33	2.85	9.33	40	20			
67.419	67.420	DRIVING LANE	14	6		9.33	2.85	9.33	40	20			
67.421	67.422	DRIVING LANE	14	6		9.33	2.85	9.33	40	20			
67.424	67.425	DRIVING LANE	14	6		9.33	2.85	9.33	40	20			
67.434	67.435	DRIVING LANE	14	6		9.33	2.85	9.33	40	20			
67.436	67.437	DRIVING LANE	14	6		9.33	2.85	9.33	40	20			
67.588	67.590	DRIVING LANE	14	12		18.67	5.70	18.67	52	20			0.12
67.697	67.698	DRIVING LANE	14	6		9.33	2.85	9.33	40	20			
67.720	67.722	DRIVING LANE	14	11		17.11	5.23	17.11	50	20			0.11
67.740	67.741	DRIVING LANE	14	6		9.33	2.85	9.33	40	20			
67.846	67.847	DRIVING LANE	14	6		9.33	2.85	9.33	40	20			
67.846	67.847	DRIVING LANE	14	6		9.33	2.85	9.33	40	20			
67.853	67.856	DRIVING LANE	14	16		24.89	7.61	24.89	60	20			0.16
67.880	67.881	DRIVING LANE	14	6		9.33	2.85	9.33	40	20			
68.001	68.003	DRIVING LANE	14	10		15.56	4.75	15.56	48	20			0.1
68.064	68.065	DRIVING LANE	14	6		9.33	2.85	9.33	40	20			
68.068	68.069	DRIVING LANE	14	6		9.33	2.85	9.33	40	20			
68.076	68.078	DRIVING LANE	14	11		17.11	5.23	17.11	50	20			0.11
68.086	68.088	DRIVING LANE	14	11		17.11	5.23	17.11	50	20			0.11
68.115	68.116	DRIVING LANE	14	6		9.33	2.85	9.33	40	20			
68.117	68.118	DRIVING LANE	14	6		9.33	2.85	9.33	40	20			
68.132	68.133	DRIVING LANE	14	6		9.33	2.85	9.33	40	20			
68.182	68.183	DRIVING LANE	14	6		9.33	2.85	9.33	40	20			
68.199	68.200	DRIVING LANE	14	6		9.33	2.85	9.33	40	20			
68.540	68.541	DRIVING LANE	14	6		9.33	2.85	9.33	40	20			
68.557	68.558	DRIVING LANE	14	6		9.33	2.85	9.33	40	20			
68.580	68.581	DRIVING LANE	14	6		9.33	2.85	9.33	40	20			
68.589	68.590	DRIVING LANE	14	6		9.33	2.85	9.33	40	20			
68.603	68.604	DRIVING LANE	14	6		9.33	2.85	9.33	40	20			
68.703	68.704	DRIVING LANE	14	6		9.33	2.85	9.33	40	20			
68.829	68.833	DRIVING LANE	14	20		31.11	9.51	31.11	68	20			0.2
68.852	68.853	DRIVING LANE	14	6		9.33	2.85	9.33	40	20			
68.859	68.865	DRIVING LANE	14	32		49.78	15.21	49.78	116	20	20	13	0.32
68.864	68.865	DRIVING LANE	14	6		9.33	2.85	9.33	40	20			
				SUBTOTAL		667.19	203.84	667.19	2422	1100	20	13	2

SUMMARY OF QUANTITIES
SHEET 2 OF 19

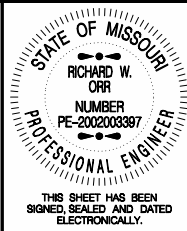

DATE PREPARED 4/10/2024	
ROUTE I - 35	STATE MO
DISTRICT NW	SHEET NO. 3


COUNTY
CLINTON

JOB NO.
JNW0129

CONTRACT ID.

PROJECT NO.

BRIDGE NO.

 [illegible]

MISSOURI HIGHWAYS AND TRANSPORTATION
COMMISSION

105 WEST CAPITAL
JEFFERSON CITY, MO 65102
1-888-ASK-MODOT (1-888-275-6636)


REMOVAL FOR FULL DEPTH REPAIRS,
UNBONDED CONCRETE OVERLAY

1 REVISED

PAVEMENT REPAIR SOUTH BOUND SHEET 3

LOG MILE		LOCATION	WIDTH	LENGTH	PARTIAL DEPTH PAVEMENT REPAIR		FULL DEPTH REPAIRS OF UNBONDED CONCRETE OVERLAY						PORTLAND CEMENT CONCRETE SHOULDER RUMBLE STRIP STA.
					REVISED REMOVAL FOR PARTIAL DEPTH PAVEMENT REPAIR	FURNISHING AND PLACING CONCRETE MATERIAL	UNBONDED CONCRETE OVERLAY INTERLAYER	SAW CUTS INTERNAL AND PERIMETER	DOWEL BAR (DRILLING, FURNISHING, AND INSTALLATION EACH	DOWEL BAR (FURNISHING AND INSTALLATION WITH BASKETS) EACH	TIE BAR (DRILLING, FURNISHING AND INSTALLATION) EACH		
FROM	TO				S.Y.	C.Y.	S.Y.	L.F.					
68.869	68.875	DRIVING LANE	14	30	46.67	14.26	46.67	112	20	20	12	0.3	
68.880	68.891	DRIVING LANE	14	60	93.33	28.52	93.33	196	20	40	24	0.6	
68.901	68.905	DRIVING LANE	14	21	32.67	9.98	32.67	70	20			0.21	
68.920	68.921	DRIVING LANE	14	6	9.33	2.85	9.33	40	20				
68.926	68.927	DRIVING LANE	14	6	9.33	2.85	9.33	40	20				
68.929	68.930	DRIVING LANE	14	6	9.33	2.85	9.33	40	20				
68.932	68.933	DRIVING LANE	14	6	9.33	2.85	9.33	40	20				
68.941	68.942	DRIVING LANE	14	6	9.33	2.85	9.33	40	20				
69.008	69.010	DRIVING LANE	14	12	18.67	5.70	18.67	52	20			0.12	
69.011	69.012	DRIVING LANE	14	6	9.33	2.85	9.33	40	20				
69.013	69.014	DRIVING LANE	14	6	9.33	2.85	9.33	40	20				
69.035	69.036	DRIVING LANE	14	6	9.33	2.85	9.33	40	20				
69.035	69.036	DRIVING LANE	14	6	9.33	2.85	9.33	40	20				
69.042	69.043	DRIVING LANE	14	6	9.33	2.85	9.33	40	20				
69.079	69.080	DRIVING LANE	14	6	9.33	2.85	9.33	40	20				
69.081	69.082	DRIVING LANE	14	6	9.33	2.85	9.33	40	20				
69.247	69.250	DRIVING LANE	14	18	28.00	8.56	28.00	64	20			0.18	
69.260	69.263	DRIVING LANE	14	18	28.00	8.56	28.00	64	20			0.18	
69.283	69.284	DRIVING LANE	14	6	9.33	2.85	9.33	40	20				
69.288	69.289	DRIVING LANE	14	6	9.33	2.85	9.33	40	20				
69.292	69.295	DRIVING LANE	14	18	28.00	8.56	28.00	64	20			0.18	
69.301	69.302	DRIVING LANE	14	6	9.33	2.85	9.33	40	20				
69.323	69.324	DRIVING LANE	14	6	9.33	2.85	9.33	40	20				
69.335	69.336	DRIVING LANE	14	6	9.33	2.85	9.33	40	20				
69.349	69.350	DRIVING LANE	14	6	9.33	2.85	9.33	40	20				
69.414	69.415	DRIVING LANE	14	6	9.33	2.85	9.33	40	20				
69.434	69.435	DRIVING LANE	14	6	9.33	2.85	9.33	40	20				
69.437	69.438	DRIVING LANE	14	6	9.33	2.85	9.33	40	20				
69.440	69.444	DRIVING LANE	14	22	34.22	10.46	34.22	72	20			0.22	
69.465	69.466	DRIVING LANE	14	6	9.33	2.85	9.33	40	20				
69.470	69.471	DRIVING LANE	14	6	9.33	2.85	9.33	40	20				
69.478	69.479	DRIVING LANE	14	6	9.33	2.85	9.33	40	20				
69.489	69.504	DRIVING LANE	14	80	124.44	38.02	124.44	248	20	50	32	0.8	
69.507	69.508	DRIVING LANE	14	6	9.33	2.85	9.33	40	20				
69.524	69.525	DRIVING LANE	14	6	9.33	2.85	9.33	40	20				
69.533	69.534	DRIVING LANE	14	6	9.33	2.85	9.33	40	20				
69.539	69.540	DRIVING LANE	14	6	9.33	2.85	9.33	40	20				
69.541	69.542	DRIVING LANE	14	6	9.33	2.85	9.33	40	20				
69.555	69.556	DRIVING LANE	14	6	9.33	2.85	9.33	40	20				
69.558	69.559	DRIVING LANE	14	6	9.33	2.85	9.33	40	20				
69.564	69.565	DRIVING LANE	14	6	9.33	2.85	9.33	40	20				
69.569	69.570	DRIVING LANE	14	6	9.33	2.85	9.33	40	20				
69.572	69.573	DRIVING LANE	14	6	9.33	2.85	9.33	40	20				
69.575	69.576	DRIVING LANE	14	6	9.33	2.85	9.33	40	20				
69.587	69.588	DRIVING LANE	14	6	9.33	2.85	9.33	40	20				
69.598	69.599	DRIVING LANE	14	6	9.33	2.85	9.33	40	20				
69.602	69.603	DRIVING LANE	14	6	9.33	2.85	9.33	40	20				
69.605	69.606	DRIVING LANE	14	6	9.33	2.85	9.33	40	20				
69.608	69.609	DRIVING LANE	14	6	9.33	2.85	9.33	40	20				
69.612	69.616	DRIVING LANE	14	20	31.11	9.51	31.11	68	20			0.2	
69.616	69.617	DRIVING LANE	14	6	9.33	2.85	9.33	40	20				
69.620	69.622	DRIVING LANE	14	8	12.44	3.80	12.44	44	20				
69.627	69.630	DRIVING LANE	14	18	28.00	8.56	28.00	64	20			0.18	
69.638	69.647	DRIVING LANE	14	50	77.78	23.77	77.78	164	20	30	20	0.5	
69.648	69.649	DRIVING LANE	14	6	9.33	2.85	9.33	40	20				
69.657	69.658	DRIVING LANE	14	6	9.33	2.85	9.33	40	20				
69.660	69.661	DRIVING LANE	14	6	9.33	2.85	9.33	40	20				
69.671	69.672	DRIVING LANE	14	6	9.33	2.85	9.33	40	20				
69.679	69.697	DRIVING LANE	14	94	146.22	44.68	146.22	288	20	60	38	0.94	
69.709	69.730	DRIVING LANE	14	110	171.11	52.28	171.11	332	20	70	44	1.1	
69.726	69.747	DRIVING LANE	14	110	171.11	52.28	171.11	332	20	70	44	1.1	
69.749	69.750	DRIVING LANE	14	6	9.33	2.85	9.33	40	20				
69.751	69.752	DRIVING LANE	14	6	9.33	2.85	9.33	40	20				
69.754	69.755	DRIVING LANE	14	6	9.33	2.85	9.33	40	20				
				SUBTOTAL	1519.61	464.30	1519.61	4154.00	1280.00	340.00	214.00	6.81	

SUMMARY OF QUANTITIES
SHEET 3 OF 19

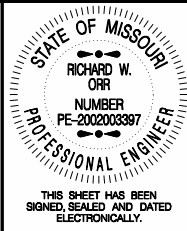


DATE PREPARED	
4/10/2024	
ROUTE	STATE
I - 35	MO
DISTRICT	SHEET NO.
NW	3

COUNTY	CLINTON
JOB NO.	JNW0129
CONTRACT ID.	

PROJECT NO.

BRIDGE NO.

DATE	DESCRIPTION
4/9/24	DESCRIPTION CHANGE.

 

MISSOURI HIGHWAYS AND TRANSPORTATION
COMMISSION

REMOVAL FOR FULL DEPTH REPAIRS,
UNBONDED CONCRETE OVERLAY

1 REVISED PAVEMENT REPAIR NORTH BOUND SHEET 6																			
LOG MILE		LOCATION	WIDTH	LENGTH	1	REMOVED FOR PARTIAL DEPTH PAVEMENT REPAIR							FULL DEPTH REPAIRS OF UNBONDED CONCRETE OVERLAY						
					REMOVED FOR PARTIAL DEPTH PAVEMENT REPAIR	FURNISHING AND PLACING CONCRETE MATERIAL	UNBONDED CONCRETE OVERLAY INTERLAYER	SAW CUTS INTERNAL AND PERIMETER	DOWEL BAR (DRILLING, FURNISHING, AND INSTALLATION EACH	DOWEL BAR (FURNISHING AND INSTALLATION WITH BASKETS) EACH	TIE BAR (DRILLING, FURNISHING AND INSTALLATION) EACH	PORTLAND CEMENT CONCRETE SHOULDER RUMBLE STRIP STA.							
FROM	TO	LOCATION	WIDTH	LENGTH	S.Y.	C.Y.	S.Y.	L.F.	EACH	EACH	EACH	STA.							
41.986	41.987	DRIVING_LANE	12	6	8.00	2.44	8.00	36	20										
41.986	41.987	DRIVING_LANE	12	6	8.00	2.44	8.00	36	20										
42.005	42.006	DRIVING_LANE	12	6	8.00	2.44	8.00	36	20										
42.036	42.042	DRIVING_LANE	12	32	42.67	13.04	42.67	112	20	20	13								
42.052	42.053	DRIVING_LANE	12	6	8.00	2.44	8.00	36	20										
42.062	42.063	DRIVING_LANE	12	6	8.00	2.44	8.00	36	20										
42.084	42.087	DRIVING_LANE	12	15	20.00	6.11	20.00	54	20										
42.201	42.205	DRIVING_LANE	12	20	26.67	8.15	26.67	64	20										
42.332	42.334	DRIVING_LANE	12	8	10.67	3.26	10.67	40	20										
42.354	42.355	DRIVING_LANE	12	6	8.00	2.44	8.00	36	20										
42.357	42.358	DRIVING_LANE	12	6	8.00	2.44	8.00	36	20										
42.383	42.384	DRIVING_LANE	12	6	8.00	2.44	8.00	36	20										
42.428	42.434	DRIVING_LANE	12	30	40.00	12.22	40.00	108	20	20	12								
42.454	42.469	DRIVING_LANE	12	78	104.00	31.78	104.00	240	20	50	31								
42.493	42.497	DRIVING_LANE	12	19	25.33	7.74	25.33	62	20										
42.517	42.519	DRIVING_LANE	12	10	13.33	4.07	13.33	44	20										
42.533	42.535	DRIVING_LANE	12	8	10.67	3.26	10.67	40	20										
42.543	42.544	DRIVING_LANE	12	6	8.00	2.44	8.00	36	20										
42.586	42.587	DRIVING_LANE	12	6	8.00	2.44	8.00	36	20										
42.754	42.765	DRIVING_LANE	12	60	80.00	24.44	80.00	192	20	40	24								
42.917	42.925	DRIVING_LANE	12	40	53.33	16.30	53.33	128	20	20	16								
42.950	42.958	DRIVING_LANE	12	40	53.33	16.30	53.33	128	20	20	16								
42.973	42.979	DRIVING_LANE	12	30	40.00	12.22	40.00	108	20	20	12								
42.982	42.985	DRIVING_LANE	12	15	20.00	6.11	20.00	54	20										
43.122	43.126	DRIVING_LANE	12	22	29.33	8.96	29.33	68	20										
43.166	43.180	DRIVING_LANE	12	75	100.00	30.56	100.00	234	20	50	30								
43.208	43.228	DRIVING_LANE	12	105	140.00	42.78	140.00	318	20	70	42								
43.258	43.260	DRIVING_LANE	12	10	13.33	4.07	13.33	44	20										
43.286	43.288	DRIVING_LANE	12	8	10.67	3.26	10.67	40	20										
43.337	43.346	DRIVING_LANE	12	45	60.00	18.33	60.00	150	20	30	18								
43.817	43.818	DRIVING_LANE	12	6	8.00	2.44	8.00	36	20										
43.827	43.832	DRIVING_LANE	12	27	36.00	11.00	36.00	78	20										
43.909	43.915	DRIVING_LANE	12	34	45.33	13.85	45.33	116	20	20	14								
43.914	43.915	DRIVING_LANE	12	6	8.00	2.44	8.00	36	20										
43.919	43.925	DRIVING_LANE	12	34	45.33	13.85	45.33	116	20	20	14								
43.933	43.936	DRIVING_LANE	12	18	24.00	7.33	24.00	60	20										
43.941	43.942	DRIVING_LANE	12	6	8.00	2.44	8.00	36	20										
43.950	43.959	DRIVING_LANE	12	50	66.67	20.37	66.67	160	20	30	20								
43.969	43.970	DRIVING_LANE	12	6	8.00	2.44	8.00	36	20										
43.980	43.986	DRIVING_LANE	12	34	45.33	13.85	45.33	116	20	20	14								
44.050	44.051	DRIVING_LANE	12	6	8.00	2.44	8.00	36	20										
44.090	44.091	DRIVING_LANE	12	6	8.00	2.44	8.00	36	20										
44.116	44.130	DRIVING_LANE	12	75	100.00	30.56	100.00	234	20	50	30								
44.118	44.124	DRIVING_LANE	12	30	40.00	12.22	40.00	108	20	20	12								
44.193	44.194	DRIVING_LANE	12	6	8.00	2.44	8.00	36	20										
44.426	44.428	DRIVING_LANE	12	10	13.33	4.07	13.33	44	20										
44.833	44.834	DRIVING_LANE	12	6	8.00	2.44	8.00	36	20										
45.465	45.466	DRIVING_LANE	12	6	8.00	2.44	8.00	36	20										
45.467	45.468	DRIVING_LANE	12	6	8.00	2.44	8.00	36	20										
45.475	45.481	DRIVING_LANE	12	34	45.33	13.85	45.33	116	20	20	14								
45.500	45.501	DRIVING_LANE	12	6	8.00	2.44	8.00	36	20										
45.528	45.534	DRIVING_LANE	12	34	45.33	13.85	45.33	116	20	20	14								
45.590	45.605	DRIVING_LANE	12	80	106.67	32.59	106.67	244	20	50	32								
45.595	45.596	DRIVING_LANE	12	6	8.00	2.44	8.00	36	20										
45.598	45.599	DRIVING_LANE	12	6	8.00	2.44	8.00	36	20										
45.601	45.602	DRIVING_LANE	12	6	8.00	2.44	8.00	36	20										
45.604	45.605	DRIVING_LANE	12	6	8.00	2.44	8.00	36	20										
45.610	45.619	DRIVING_LANE	12	45	60.00	18.33	60.00	150	20	30	18								
45.624	45.625	DRIVING_LANE	12	6	8.00	2.44	8.00	36	20										
				SUBTOTAL	1774.65	542.12	1774.65	4822	1180	620	396	0							

SUMMARY OF QUANTITIES
SHEET 6 OF 19



DATE PREPARED	
4/10/2024	
ROUTE	STATE
I - 35	MO
DISTRICT	SHEET NO.
NW	3

COUNTY
CLINTON

JOB NO.
JNW0129

CONTRACT ID.

PROJECT NO.

BRIDGE NO.							

DATE	DESCRIPTION
4/9/74	DESCRIPTION CHANGE.



MISSOURI HIGHWAYS AND TRANSPORTATION
COMMISSION


105 WEST CAPITOL
JEFFERSON CITY, MO 65102
1-888-ASK-MODOT (1-888-275-6636)

--

REMOVAL FOR FULL DEPTH REPAIRS,
UNBONDED CONCRETE OVERLAY

PAVEMENT REPAIR NORTH BOUND SHEET 7												
LOG MILE		LOCATION	WIDTH	LENGTH	1	PAVEMENT REPAIRS OF UNBONDED CONCRETE OVERLAY						
					REMOVED FOR PARTIAL DEPTH PAVEMENT REPAIR	FURNISHING AND PLACING CONCRETE MATERIAL	UNBONDED CONCRETE OVERLAY INTERLAYER	SAW CUTS INTERNAL AND PERIMETER	DOWEL BAR (DRILLING, FURNISHING, AND INSTALLATION EACH	DOWEL BAR (FURNISHING AND INSTALLATION WITH BASKETS) EACH	TIE BAR (DRILLING, FURNISHING AND INSTALLATION) EACH	PORTLAND CEMENT CONCRETE SHOULDER RUMBLE STRIP STA.
FROM	TO				S.Y.	C.Y.	S.Y.	L.F.				
45.649	45.650	DRIVING_LANE	12	6	8.00	2.44	8.00	36	20			
45.653	45.654	DRIVING_LANE	12	6	8.00	2.44	8.00	36	20			
45.654	45.655	DRIVING_LANE	12	6	8.00	2.44	8.00	36	20			
45.657	45.658	DRIVING_LANE	12	6	8.00	2.44	8.00	36	20			
45.660	45.672	DRIVING_LANE	12	64	85.33	26.07	85.33	200	20	40	26	
45.683	45.684	DRIVING_LANE	12	6	8.00	2.44	8.00	36	20			
45.689	45.695	DRIVING_LANE	12	34	45.33	13.85	45.33	116	20	20	14	
45.698	45.699	DRIVING_LANE	12	6	8.00	2.44	8.00	36	20			
45.700	45.701	DRIVING_LANE	12	6	8.00	2.44	8.00	36	20			
45.717	45.718	DRIVING_LANE	12	6	8.00	2.44	8.00	36	20			
45.720	45.721	DRIVING_LANE	12	6	8.00	2.44	8.00	36	20			
45.723	45.724	DRIVING_LANE	12	6	8.00	2.44	8.00	36	20			
45.740	45.741	DRIVING_LANE	12	6	8.00	2.44	8.00	36	20			
45.759	45.777	DRIVING_LANE	12	94	125.33	38.30	125.33	284	20	60	38	
45.774	45.801	DRIVING_LANE	12	140	186.67	57.04	186.67	412	20	90	56	
45.796	45.805	DRIVING_LANE	12	50	66.67	20.37	66.67	160	20	30	20	
45.808	45.809	DRIVING_LANE	12	6	8.00	2.44	8.00	36	20			
45.810	45.811	DRIVING_LANE	12	6	8.00	2.44	8.00	36	20			
45.813	45.816	DRIVING_LANE	12	18	24.00	7.33	24.00	60	20			
45.821	45.822	DRIVING_LANE	12	6	8.00	2.44	8.00	36	20			
45.841	45.842	DRIVING_LANE	12	6	8.00	2.44	8.00	36	20			
45.858	45.859	DRIVING_LANE	12	6	8.00	2.44	8.00	36	20			
45.862	45.863	DRIVING_LANE	12	6	8.00	2.44	8.00	36	20			
45.865	45.866	DRIVING_LANE	12	6	8.00	2.44	8.00	36	20			
46.257	46.258	DRIVING_LANE	12	6	8.00	2.44	8.00	36	20			
46.271	46.272	DRIVING_LANE	12	6	8.00	2.44	8.00	36	20			
46.271	46.272	DRIVING_LANE	12	6	8.00	2.44	8.00	36	20			
46.276	46.279	DRIVING_LANE	12	18	24.00	7.33	24.00	60	20			
46.316	46.317	DRIVING_LANE	12	6	8.00	2.44	8.00	36	20			
46.342	46.343	DRIVING_LANE	12	6	8.00	2.44	8.00	36	20			
46.367	46.376	DRIVING_LANE	12	50	66.67	20.37	66.67	160	20	30	20	
46.387	46.408	DRIVING_LANE	12	110	146.67	44.82	146.67	328	20	70	44	
46.456	46.483	DRIVING_LANE	12	140	186.67	57.04	186.67	412	20	90	56	
46.470	46.471	DRIVING_LANE	12	6	8.00	2.44	8.00	36	20			
46.475	46.476	DRIVING_LANE	12	6	8.00	2.44	8.00	36	20			
46.478	46.479	DRIVING_LANE	12	6	8.00	2.44	8.00	36	20			
46.487	46.488	DRIVING_LANE	12	6	8.00	2.44	8.					

SUMMARY OF QUANTITIES
SHEET 7 OF 19

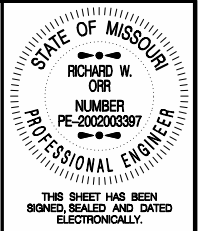

DATE PREPARED	
4/10/2024	
ROUTE	STATE
I - 35	MO
DISTRICT	SHEET NO.
NW	3
COUNTY	
CLINTON	
JOB NO.	
JNW0129	
CONTRACT ID.	

PROJECT NO.
BRIDGE NO.

DATE	DESCRIPTION
4/9/24	DESCRIPTION CHANGE.



MISSOURI HIGHWAYS AND TRANSPORTATION
COMMISSION

105 WEST CAPITOL
JEFFERSON CITY, MO 65102
1-888-ASK-MODOT (1-888-275-6636)

REMOVAL FOR FULL DEPTH REPAIRS,
UNBONDED CONCRETE OVERLAY

PAVEMENT REPAIR NORTH BOUND SHEET 8												
LOG MILE		LOCATION	WIDTH	LENGTH	REMOVED FOR PARTIAL DEPTH PAVEMENT REPAIR	FURNISHING AND PLACING CONCRETE MATERIAL	UNBONDED CONCRETE OVERLAY INTERLAYER	SAW CUTS INTERNAL AND PERIMETER	DOWEL BAR (DRILLING, FURNISHING, AND INSTALLATION EACH	DOWEL BAR (FURNISHING AND INSTALLATION WITH BASKETS) EACH	TIE BAR (DRILLING, FURNISHING AND INSTALLATION) EACH	PORTLAND CEMENT CONCRETE SHOULDER RUMBLE STRIP STA.
					S.Y.	C.Y.	S.Y.	L.F.				
46.628	46.629	DRIVING_LANE	12	6	8.00	2.44	8.00	36	20			
46.631	46.632	DRIVING_LANE	12	6	8.00	2.44	8.00	36	20			
46.636	46.637	DRIVING_LANE	12	6	8.00	2.44	8.00	36	20			
46.640	46.646	DRIVING_LANE	12	34	45.33	13.85	45.33	116	20	20	14	
46.648	46.649	DRIVING_LANE	12	6	8.00	2.44	8.00	36	20			
46.651	46.654	DRIVING_LANE	12	18	24.00	7.33	24.00	60	20			
46.657	46.658	DRIVING_LANE	12	6	8.00	2.44	8.00	36	20			
46.685	46.686	DRIVING_LANE	12	6	8.00	2.44	8.00	36	20			
46.688	46.689	DRIVING_LANE	12	6	8.00	2.44	8.00	36	20			
46.691	46.692	DRIVING_LANE	12	6	8.00	2.44	8.00	36	20			
46.696	46.697	DRIVING_LANE	12	6	8.00	2.44	8.00	36	20			
46.703	46.705	DRIVING_LANE	12	10	13.33	4.07	13.33	44	20			
46.708	46.709	DRIVING_LANE	12	6	8.00	2.44	8.00	36	20			
46.717	46.718	DRIVING_LANE	12	6	8.00	2.44	8.00	36	20			
46.719	46.720	DRIVING_LANE	12	6	8.00	2.44	8.00	36	20			
46.725	46.726	DRIVING_LANE	12	6	8.00	2.44	8.00	36	20			
46.753	46.754	DRIVING_LANE	12	6	8.00	2.44	8.00	36	20			
46.782	46.783	DRIVING_LANE	12	6	8.00	2.44	8.00	36	20			
46.786	46.787	DRIVING_LANE	12	6	8.00	2.44	8.00	36	20			
46.790	46.791	DRIVING_LANE	12	6	8.00	2.44	8.00	36	20			
46.793	46.796	DRIVING_LANE	12	18	24.00	7.33	24.00	60	20			
46.804	46.805	DRIVING_LANE	12	6	8.00	2.44	8.00	36	20			
46.819	46.820	DRIVING_LANE	12	6	8.00	2.44	8.00	36	20			
46.827	46.833	DRIVING_LANE	12	30	40.00	12.22	40.00	108	20	20	12	
46.836	46.837	DRIVING_LANE	12	6	8.00	2.44	8.00	36	20			
46.869	46.870	DRIVING_LANE	12	6	8.00	2.44	8.00	36	20			
46.882	46.906	DRIVING_LANE	12	125	166.67	50.93	166.67	370	20	80	50	
46.910	46.911	DRIVING_LANE	12	6	8.00	2.44	8.00	36	20			
46.913	46.914	DRIVING_LANE	12	6	8.00	2.44	8.00	36	20			
46.925	46.926	DRIVING_LANE	12	6	8.00	2.44	8.00	36	20			
46.927	46.928	DRIVING_LANE	12	6	8.00	2.44	8.00	36	20			
46.941	46.942	DRIVING_LANE	12	6	8.00	2.44	8.00	36	20			
46.945	46.946	DRIVING_LANE	12	6	8.00	2.44	8.00	36	20			
46.948	46.949	DRIVING_LANE	12	6	8.00	2.44	8.00	36	20			
46.959	46.960	DRIVING_LANE	12	6	8.00	2.44	8.00	36	20			
46.962	46.969	DRIVING_LANE	12	38	50.67	15.48	50.67	124	20	20	15	
46.979	46.980	DRIVING_LANE	12	6	8.00	2.44	8.00	36	20			
46.983	46.984	DRIVING_LANE	12	6	8.00	2.44	8.00	36	20			
46.986	46.987	DRIVING_LANE	12	6	8.00	2.44	8.00	36	20			
47.011	47.012	DRIVING_LANE	12	6	8.00	2.44	8.00	36	20			
47.019	47.020	DRIVING_LANE	12	6	8.00	2.44	8.00	36	20			
47.038	47.039	DRIVING_LANE	12	6	8.00	2.44	8.00	36	20			
47.040	47.058	DRIVING_LANE	12	96	128.00	39.11	128.00	288	20	60	38	
47.041	47.042	DRIVING_LANE	12	6	8.00	2.44	8.00	36	20			
47.100	47.101	DRIVING_LANE	12	6	8.00	2.44	8.00	36	20			
47.102	47.103	DRIVING_LANE	12	6	8.00	2.44	8.00	36	20			
47.108	47.109	DRIVING_LANE	12	6	8.00	2.44	8.00	36	20			
47.109	47.110	DRIVING_LANE	12	6	8.00	2.44	8.00	36	20			
47.119	47.120	DRIVING_LANE	12	6	8.00	2.44	8.00	36	20			
47.125	47.126	DRIVING_LANE	12	6	8.00	2.44	8.00	36	20			
47.129	47.130	DRIVING_LANE	12	6	8.00	2.44	8.00	36	20			
47.135	47.136	DRIVING_LANE	12	6	8.00	2.44	8.00	36	20			
47.141	47.144	DRIVING_LANE	12	18	24.00	7.33	24.00	60	20			
47.200	47.201	DRIVING_LANE	12	6	8.00	2.44	8.00	36	20			
47.203	47.204	DRIVING_LANE	12	6	8.00	2.44	8.00	36	20			
47.209	47.210	DRIVING_LANE	12	6	8.00	2.44	8.00	36	20			
47.212	47.213	DRIVING_LANE	12	6	8.00	2.44	8.00	36	20			
47.214	47.215	DRIVING_LANE	12	6	8.00	2.44	8.00	36	20			
47.216	47.217	DRIVING_LANE	12	6	8.00	2.44	8.00	36	20			
				SUBTOTAL	916.00	279.65	916.00	3030	1180	200	129	0

SUMMARY OF QUANTITIES
SHEET 8 OF 19



THIS SHEET HAS BEEN
SIGNED, SEALED AND DATED
ELECTRONICALLY.

DATE PREPARED
4/10/2024

ROUTE	STATE
I - 35	MO

DISTRICT NW	SHEET NO. 3
----------------	----------------

COUNTY
CLINTON

JOB NO.
JNW0129

CONTRACT ID.

PROJECT NO.

BRIDGE NO.

DATE	DESCRIPTION
4/9/24	DESCRIPTION CHANGE.



MISSOURI HIGHWAYS AND TRANSPORTATION
COMMISSION

105 WEST CAPITAL
JEFFERSON CITY, MO 65102
1-888-ASK-MODOT (1-888-275-6636)

--

REMOVAL FOR FULL DEPTH REPAIRS,
UNBONDED CONCRETE OVERLAY

PAVEMENT REPAIR NORTH BOUND SHEET 9												
LOG MILE		LOCATION	WIDTH	LENGTH	1	FURNISHING AND PLACING CONCRETE MATERIAL	UNBONDED CONCRETE OVERLAY INTERLAYER	SAW CUTS INTERNAL AND PERIMETER	DOWEL BAR (DRILLING, FURNISHING, AND INSTALLATION EACH	DOWEL BAR (FURNISHING AND INSTALLATION WITH BASKETS) EACH	TIE BAR (DRILLING, FURNISHING AND INSTALLATION) EACH	PORTLAND CEMENT CONCRETE SHOULDER RUMBLE STRIP STA.
					REMOVED REMOVAL FOR PARTIAL DEPTH PAVEMENT REPAIR							
FROM	TO				S.Y.	C.Y.	S.Y.	L.F.				
47.277	47.278	DRIVING_LANE	12	6	8.00	2.44	8.00	36	20			
47.282	47.283	DRIVING_LANE	12	6	8.00	2.44	8.00	36	20			
47.284	47.285	DRIVING_LANE	12	6	8.00	2.44	8.00	36	20			
47.345	47.347	DRIVING_LANE	12	8	10.67	3.26	10.67	40	20			
47.359	47.364	DRIVING_LANE	12	28	37.33	11.41	37.33	80	20			
47.364	47.365	DRIVING_LANE	12	6	8.00	2.44	8.00	36	20			
47.370	47.371	DRIVING_LANE	12	6	8.00	2.44	8.00	36	20			
47.375	47.376	DRIVING_LANE	12	6	8.00	2.44	8.00	36	20			
47.378	47.379	DRIVING_LANE	12	6	8.00	2.44	8.00	36	20			
47.381	47.382	DRIVING_LANE	12	6	8.00	2.44	8.00	36	20			
47.384	47.385	DRIVING_LANE	12	6	8.00	2.44	8.00	36	20			
47.387	47.396	DRIVING_LANE	12	45	60.00	18.33	60.00	150	20	30	18	
47.396	47.397	DRIVING_LANE	12	6	8.00	2.44	8.00	36	20			
47.398	47.399	DRIVING_LANE	12	6	8.00	2.44	8.00	36	20			
47.400	47.401	DRIVING_LANE	12	6	8.00	2.44	8.00	36	20			
47.403	47.404	DRIVING_LANE	12	6	8.00	2.44	8.00	36	20			
47.407	47.408	DRIVING_LANE	12	6	8.00	2.44	8.00	36	20			
47.410	47.411	DRIVING_LANE	12	6	8.00	2.44	8.00	36	20			
47.410	47.411	DRIVING_LANE	12	6	8.00	2.44	8.00	36	20			
47.414	47.415	DRIVING_LANE	12	6	8.00	2.44	8.00	36	20			
47.420	47.421	DRIVING_LANE	12	6	8.00	2.44	8.00	36	20			
47.422	47.423	DRIVING_LANE	12	6	8.00	2.44	8.00	36	20			
47.446	47.447	DRIVING_LANE	12	6	8.00	2.44	8.00	36	20			
47.466	47.467	DRIVING_LANE	12	6	8.00	2.44	8.00	36	20			
47.468	47.470	DRIVING_LANE	12	10	13.33	4.07	13.33	44	20			
47.477	47.478	DRIVING_LANE	12	6	8.00	2.44	8.00	36	20			
47.479	47.480	DRIVING_LANE	12	6	8.00	2.44	8.00	36	20			
47.483	47.484	DRIVING_LANE	12	6	8.00	2.44	8.00	36	20			
47.490	47.493	DRIVING_LANE	12	18	24.00	7.33	24.00	60	20			
47.513	47.519	DRIVING_LANE	12	30	40.00	12.22	40.00	108	20	20	12	
47.524	47.525	DRIVING_LANE	12	6	8.00	2.44	8.00	36	20			
47.539	47.540	DRIVING_LANE	12	6	8.00	2.44	8.00	36	20			
47.582	47.606	DRIVING_LANE	12	125	166.67	50.93	166.67	370	20	80	50	
47.589	47.590	DRIVING_LANE	12	6	8.00	2.44	8.00	36	20			
47.591	47.592	DRIVING_LANE	12	6	8.00	2.44	8.00	36	20			
47.594	47.595	DRIVING_LANE	12	6	8.00	2.44	8.00	36	20			
47.595	47.596	DRIVING_LANE	12	6	8.00	2.44	8.00	36	20			
47.602	47.603	DRIVING_LANE	12	6	8.00	2.44	8.00	36	20			
47.609	47.610	DRIVING_LANE	12	6	8.00	2.44	8.00	36	20			
47.612	47.613	DRIVING_LANE	12	6	8.00	2.44	8.00	36	20			
47.618	47.619	DRIVING_LANE	12	6	8.00	2.44	8.00	36	20			
47.625	47.626	DRIVING_LANE	12	6	8.00	2.44	8.00	36	20			
47.627	47.628	DRIVING_LANE	12	6	8.00	2.44	8.00	36	20			
47.630	47.631	DRIVING_LANE	12	6	8.00	2.44	8.00	36	20			
47.631	47.632	DRIVING_LANE	12	6	8.00	2.44	8.00	36	20			
47.634	47.635	DRIVING_LANE	12	6	8.00	2.44	8.00	36	20			
47.639	47.640	DRIVING_LANE	12	6	8.00	2.44	8.00	36	20			
47.642	47.643	DRIVING_LANE	12	6	8.00	2.44	8.00	36	20			
47.643	47.644	DRIVING_LANE	12	6	8.00	2.44	8.00	36	20			
47.645	47.651	DRIVING_LANE	12	30	40.00	12.22	40.00	108	20	20	12	
47.652	47.653	DRIVING_LANE	12	6	8.00	2.44	8.00	36	20			
47.653	47.654	DRIVING_LANE	12	6	8.00	2.44	8.00	36	20			
47.666	47.677	DRIVING_LANE	12	60	80.00	24.44	80.00	192	20	40	24	
47.672	47.706	DRIVING_LANE	12	180	240.00	73.33	240.00	528	20	120	72	
47.708	47.709	DRIVING_LANE	12	6	8.00	2.44	8.00	36	20			
47.710	47.711	DRIVING_LANE	12	6	8.00	2.44	8.00	36	20			
47.722	47.723	DRIVING_LANE	12	6	8.00	2.44	8.00	36	20			
47.725	47.726	DRIVING_LANE	12	6	8.00	2.44	8.00	36	20			
47.734	47.735	DRIVING_LANE	12	6	8.00	2.44	8.00	36	20			
SUBTOTAL					1104.00	337.10	1104.00	3444	1180	310	188	0

SUMMARY OF QUANTITIES
SHEET 9 OF 19



DATE PREPARED
4/10/2024
ROUTE
1-35
STATE
MO
DISTRICT
NW
SHEET NO.
3

COUNTY
CLINON
JOB NO.
JNW0129
CONTRACT ID.

PROJECT NO.
BRIDGE NO.

DATE	DESCRIPTION				
	DESCRIPTION	CHANGE			
4/9/24					

MISSOURI HIGHWAYS AND TRANSPORTATION
COMMISSION

105 WEST CAPITOL
JEFFERSON CITY, MO 65102
1-888-ASK-MODOT (1-888-275-6636)

REMOVAL FOR FULL DEPTH REPAIRS,
UNBONDED CONCRETE OVERLAY

PAVEMENT REPAIR NORTH BOUND SHEET 10												
LOG MILE		LOCATION	WIDTH	LENGTH	PARTIAL DEPTH PAVEMENT REPAIR		FULL DEPTH REPAIRS OF UNBONDED CONCRETE OVERLAY					
					S.Y.	C.Y.	UNBONDED CONCRETE OVERLAY INTERLAYER	SAW CUTS INTERNAL AND PERIMETER L.F.	DOWEL BAR (DRILLING, FURNISHING, AND INSTALLATION EACH)	DOWEL BAR (FURNISHING AND INSTALLATION WITH BASKETS) EACH	TIE BAR (DRILLING, FURNISHING AND INSTALLATION) EACH	PORTLAND CEMENT CONCRETE SHOULDER RUMBLE STRIP STA.
47.736	47.737	DRIVING_LANE	12	6	8.00	2.44	8.00	36	20			
47.740	47.741	DRIVING_LANE	12	6	8.00	2.44	8.00	36	20			
47.818	47.819	DRIVING_LANE	12	6	8.00	2.44	8.00	36	20			
47.821	47.822	DRIVING_LANE	12	6	8.00	2.44	8.00	36	20			
47.825	47.826	DRIVING_LANE	12	6	8.00	2.44	8.00	36	20			
47.844	47.845	DRIVING_LANE	12	6	8.00	2.44	8.00	36	20			
47.949	47.950	DRIVING_LANE	12	6	8.00	2.44	8.00	36	20			
47.981	47.982	DRIVING_LANE	12	6	8.00	2.44	8.00	36	20			
48.034	48.035	DRIVING_LANE	12	6	8.00	2.44	8.00	36	20			
48.040	48.043	DRIVING_LANE	12	15	20.00	6.11	20.00	54	20			
48.052	48.053	DRIVING_LANE	12	6	8.00	2.44	8.00	36	20			
48.080	48.081	DRIVING_LANE	12	6	8.00	2.44	8.00	36	20			
48.099	48.100	DRIVING_LANE	12	6	8.00	2.44	8.00	36	20			
48.100	48.101	DRIVING_LANE	12	6	8.00	2.44	8.00	36	20			
48.106	48.107	DRIVING_LANE	12	6	8.00	2.44	8.00	36	20			
48.109	48.110	DRIVING_LANE	12	6	8.00	2.44	8.00	36	20			
48.110	48.111	DRIVING_LANE	12	6	8.00	2.44	8.00	36	20			
48.180	48.181	DRIVING_LANE	12	6	8.00	2.44	8.00	36	20			
48.212	48.238	DRIVING_LANE	12	135	180.00	55.00	180.00	402	20	90	54	
48.214	48.215	DRIVING_LANE	12	6	8.00	2.44	8.00	36	20			
48.217	48.218	DRIVING_LANE	12	6	8.00	2.44	8.00	36	20			
48.223	48.227	DRIVING_LANE	12	20	26.67	8.15	26.67	64	20			
48.227	48.236	DRIVING_LANE	12	45	60.00	18.33	60.00	150	20	30	18	
				SUBTOTAL	438.67	133.95	438.67	1354	460	120	72	0

REMOVAL FOR FULL DEPTH REPAIRS,
UNBONDED CONCRETE OVERLAY

PAVEMENT REPAIR SOUTH BOUND SHEET 1												
LOG MILE		LOCATION	WIDTH	LENGTH	1	FULL DEPTH REPAIRS OF UNBONDED CONCRETE OVERLAY						
					REMOVED FOR PARTIAL DEPTH PAVEMENT REPAIR	FURNISHING AND PLACING CONCRETE MATERIAL	UNBONDED CONCRETE OVERLAY INTERLAYER	SAW CUTS INTERIAL AND PERIMETER	DOWEL BAR (DRILLING, FURNISHING, AND INSTALLATION EACH	DOWEL BAR (FURNISHING AND INSTALLATION WITH BASKETS) EACH	TIE BAR (DRILLING, FURNISHING AND INSTALLATION) EACH	PORTLAND CEMENT CONCRETE SHOULDER RUMBLE STRIP STA.
FROM	TO				S.Y.	C.Y.	S.Y.	L.F.				
66.690	66.691	PASSING_LANE	12	6	8.00	2.44	8.00	36	20			
66.693	66.694	PASSING_LANE	12	6	8.00	2.44	8.00	36	20			
66.697	66.698	PASSING_LANE	12	6	8.00	2.44	8.00	36	20			
66.748	66.749	PASSING_LANE	12	6	8.00	2.44	8.00	36	20			
66.753	66.754	PASSING_LANE	12	6	8.00	2.44	8.00	36	20			
66.876	66.877	PASSING_LANE	12	6	8.00	2.44	8.00	36	20			
66.962	66.963	PASSING_LANE	12	6	8.00	2.44	8.00	36	20			
67.121	67.122	PASSING_LANE	12	6	8.00	2.44	8.00	36	20			
67.143	67.144	PASSING_LANE	12	6	8.00	2.44	8.00	36	20			
67.147	67.148	PASSING_LANE	12	6	8.00	2.44	8.00	36	20			
68.004	68.014	PASSING_LANE	12	51	68.00	20.78	68.00	162	20	30	20	0.51
68.077	68.078	PASSING_LANE	12	6	8.00	2.44	8.00	36	20			
68.538	68.540	PASSING_LANE	12	12	16.00	4.89	16.00	48	20			0.12
68.586	68.587	PASSING_LANE	12	6	8.00	2.44	8.00	36	20			
69.831	69.832	PASSING_LANE	12	6	8.00	2.44	8.00	36	20			
70.442	70.443	PASSING_LANE	12	6	8.00	2.44	8.00	36	20			
70.667	70.668	PASSING_LANE	12	6	8.00	2.44	8.00	36	20			
70.682	70.683	PASSING_LANE	12	6	8.00	2.44	8.00	36	20			
71.336	71.337	PASSING_LANE	12	6	8.00	2.44	8.00	36	20			
71.488	71.489	PASSING_LANE	12	6	8.00	2.44	8.00	36	20			
71.495	71.496	PASSING_LANE	12	6	8.00	2.44	8.00	36	20			
71.893	71.894	PASSING_LANE	12	6	8.00	2.44	8.00	36	20			
72.467	72.468	PASSING_LANE	12	6	8.00	2.44	8.00	36	20			
SUB TOTAL					252.00	76.91	252.00	966	460	30	20	0.63

SUMMARY OF QUANTITIES
SHEET 10 OF 19



THIS SHEET HAS BEEN
SIGNED, SEALED AND DATED
ELECTRONICALLY.

DATE PREPARED
4/10/2024

ROUTE	STATE
I - 35	MO

DISTRICT	SHEET NO.
NW	3

COUNTY
CLINTON

JOB NO.
INW0129

CONTRACT ID.	
--------------	--

PROJECT NO.

BRIDGE NO.

[illegible]

MISSOURI HIGHWAYS AND TRANSPORTATION
COMMISSION

105 WEST CAPITOL
JEFFERSON CITY, MO 65102
1-888-ASK-MODOT (1-888-275-6636)



REMOVAL FOR FULL DEPTH REPAIRS,
UNBONDED CONCRETE OVERLAY

1
DEPT

REVISED

PAVEMENT REPAIR NORTH BOUND SHEET 3

LOG MILE		LOCATION	WIDTH	LENGTH	PARTIAL DEPTH PAVEMENT REPAIR		FULL DEPTH REPAIRS OF UNBONDED CONCRETE OVERLAY						PORTLAND CEMENT CONCRETE SHOULDER RUMBLE STRIP STA.
					1	REVISED REMOVAL FOR PARTIAL DEPTH PAVEMENT REPAIR	FURNISHING AND PLACING CONCRETE MATERIAL	UNBONDED CONCRETE OVERLAY INTERLAYER	SAW CUTS INTERNAL AND PERIMETER	DOWEL BAR (DRILLING, FURNISHING, AND INSTALLATION EACH	DOWEL BAR (FURNISHING AND INSTALLATION WITH BASKETS) EACH	TIE BAR (DRILLING, FURNISHING AND INSTALLATION) EACH	
FROM	TO												
43.387	43.388	PASSING_LANE	12	6	8.00	2.44	8.00	36	20				
43.388	43.389	PASSING_LANE	12	6	8.00	2.44	8.00	36	20				
43.408	43.409	PASSING_LANE	12	6	8.00	2.44	8.00	36	20				
43.415	43.416	PASSING_LANE	12	6	8.00	2.44	8.00	36	20				
43.416	43.417	PASSING_LANE	12	6	8.00	2.44	8.00	36	20				
43.420	43.421	PASSING_LANE	12	6	8.00	2.44	8.00	36	20				
43.423	43.424	PASSING_LANE	12	6	8.00	2.44	8.00	36	20				
43.434	43.435	PASSING_LANE	12	6	8.00	2.44	8.00	36	20				
43.446	43.447	PASSING_LANE	12	6	8.00	2.44	8.00	36	20				
43.457	43.458	PASSING_LANE	12	6	8.00	2.44	8.00	36	20				
43.472	43.473	PASSING_LANE	12	6	8.00	2.44	8.00	36	20				
43.475	43.476	PASSING_LANE	12	6	8.00	2.44	8.00	36	20				
43.478	43.479	PASSING_LANE	12	6	8.00	2.44	8.00	36	20				
43.489	43.490	PASSING_LANE	12	6	8.00	2.44	8.00	36	20				
43.491	43.492	PASSING_LANE	12	6	8.00	2.44	8.00	36	20				
43.497	43.498	PASSING_LANE	12	6	8.00	2.44	8.00	36	20				
43.500	43.501	PASSING_LANE	12	6	8.00	2.44	8.00	36	20				
43.503	43.504	PASSING_LANE	12	6	8.00	2.44	8.00	36	20				
43.505	43.506	PASSING_LANE	12	6	8.00	2.44	8.00	36	20				
43.508	43.509	PASSING_LANE	12	6	8.00	2.44	8.00	36	20				
43.510	43.511	PASSING_LANE	12	6	8.00	2.44	8.00	36	20				
43.520	43.521	PASSING_LANE	12	6	8.00	2.44	8.00	36	20				
43.524	43.525	PASSING_LANE	12	6	8.00	2.44	8.00	36	20				
43.560	43.561	PASSING_LANE	12	6	8.00	2.44	8.00	36	20				
43.562	43.563	PASSING_LANE	12	6	8.00	2.44	8.00	36	20				
43.564	43.565	PASSING_LANE	12	6	8.00	2.44	8.00	36	20				
43.610	43.611	PASSING_LANE	12	6	8.00	2.44	8.00	36	20				
43.613	43.614	PASSING_LANE	12	6	8.00	2.44	8.00	36	20				
43.688	43.689	PASSING_LANE	12	6	8.00	2.44	8.00	36	20				
43.690	43.691	PASSING_LANE	12	6	8.00	2.44	8.00	36	20				
43.692	43.693	PASSING_LANE	12	6	8.00	2.44	8.00	36	20				
43.695	43.696	PASSING_LANE	12	6	8.00	2.44	8.00	36	20				
43.700	43.701	PASSING_LANE	12	6	8.00	2.44	8.00	36	20				
43.710	43.711	PASSING_LANE	12	6	8.00	2.44	8.00	36	20				
43.712	43.713	PASSING_LANE	12	6	8.00	2.44	8.00	36	20				
43.712	43.713	PASSING_LANE	12	6	8.00	2.44	8.00	36	20				
43.778	43.779	PASSING_LANE	12	6	8.00	2.44	8.00	36	20				
43.852	43.853	PASSING_LANE	12	6	8.00	2.44	8.00	36	20				
43.911	43.912	PASSING_LANE	12	6	8.00	2.44	8.00	36	20				
44.011	44.012	PASSING_LANE	12	6	8.00	2.44	8.00	36	20				
44.050	44.051	PASSING_LANE	12	6	8.00	2.44	8.00	36	20				
44.056	44.057	PASSING_LANE	12	6	8.00	2.44	8.00	36	20				
44.087	44.088	PASSING_LANE	12	6	8.00	2.44	8.00	36	20				
44.107	44.108	PASSING_LANE	12	6	8.00	2.44	8.00	36	20				
44.201	44.202	PASSING_LANE	12	6	8.00	2.44	8.00	36	20				
44.289	44.290	PASSING_LANE	12	6	8.00	2.44	8.00	36	20				
44.319	44.320	PASSING_LANE	12	6	8.00	2.44	8.00	36	20				
44.325	44.326	PASSING_LANE	12	6	8.00	2.44	8.00	36	20				
44.328	44.329	PASSING_LANE	12	6	8.00	2.44	8.00	36	20				
44.340	44.341	PASSING_LANE	12	6	8.00	2.44	8.00	36	20				
44.367	44.368	PASSING_LANE	12	6	8.00	2.44	8.00	36	20				
44.374	44.375	PASSING_LANE	12	6	8.00	2.44	8.00	36	20				
44.376	44.377	PASSING_LANE	12	6	8.00	2.44	8.00	36	20				
44.380	44.381	PASSING_LANE	12	6	8.00	2.44	8.00	36	20				
44.383	44.384	PASSING_LANE	12	6	8.00	2.44	8.00	36	20				
44.386	44.387	PASSING_LANE	12	6	8.00	2.44	8.00	36	20				
44.388	44.389	PASSING_LANE	12	6	8.00	2.44	8.00	36	20				
44.391	44.392	PASSING_LANE	12	6	8.00	2.44	8.00	36	20				
44.394	44.395	PASSING_LANE	12	6	8.00	2.44	8.00	36	20				
44.397	44.398	PASSING_LANE	12	6	8.00	2.44	8.00	36	20				
44.399	44.400	PASSING_LANE	12	6	8.00	2.44	8.00	36	20				
44.403	44.404	PASSING_LANE	12	6	8.00	2.44	8.00	36	20				
44.405	44.406	PASSING_LANE	12	6	8.00	2.44	8.00	36	20				
				SUB TOTAL	504.00	153.72	504.00	2268	1260	0	0	0	

SUMMARY OF QUANTITIES
SHEET 12 OF 19



DATE PREPARED 4/10/2024	
ROUTE I - 35	STATE MO
DISTRICT NW	SHEET NO. 3

COUNTY	CLINTON
JOB NO.	JNW0129
CONTRACT ID.	

PROJECT NO.

BRIDGE NO.

[illegible]

MISSOURI HIGHWAYS AND TRANSPORTATION
COMMISSION

105 WEST CAPITOL
JEFFERSON CITY, MO 65102
1-888-ASK-MODOT (1-888-275-6636)

REMOVAL FOR FULL DEPTH REPAIRS,
UNBONDED CONCRETE OVERLAY

1

REVISED

PAVEMENT REPAIR NORTH BOUND SHEET 4

~~PARTIAL DEPTH PAVEMENT REPAIR~~

~~FULL DEPTH REPAIRS OF UNBONDED CONCRETE OVERLAY~~

1

REVISED
REMOVAL FOR
PARTIAL DEPTH
PAVEMENT REPAIR

FURNISHING AND
PLACING CONCRETE
MATERIAL

UNBONDED
CONCRETE
OVERLAY
INTERLAYER

SAW CUTS
INTERIAL AND
PERIMETER

DOWEL BAR
(DRILLING, FURNISHING,
AND INSTALLATION
EACH

DOWEL BAR
(FURNISHING AND INSTALLATION
WITH BASKETS)
EACH

TIE BAR
(DRILLING, FURNISHING
AND INSTALLATION)
EACH

PORTLAND CEMENT
CONCRETE
SHOULDER
RUMBLE STRIP
STA.

LOG MILE		LOCATION	WIDTH	LENGTH	S.Y.	C.Y.	S.Y.	L.F.	EACH	EACH	EACH	STA.
FROM	TO											
44.408	44.409	PASSING_LANE	12	6	8.00	2.44	8.00	36	20			
44.411	44.412	PASSING_LANE	12	6	8.00	2.44	8.00	36	20			
44.413	44.414	PASSING_LANE	12	6	8.00	2.44	8.00	36	20			
44.416	44.418	PASSING_LANE	12	6	8.00	2.44	8.00	36	20			
44.445	44.446	PASSING_LANE	12	6	8.00	2.44	8.00	36	20			
44.451	44.452	PASSING_LANE	12	6	8.00	2.44	8.00	36	20			
44.484	44.485	PASSING_LANE	12	6	8.00	2.44	8.00	36	20			
44.527	44.528	PASSING_LANE	12	6	8.00	2.44	8.00	36	20			
44.530	44.531	PASSING_LANE	12	6	8.00	2.44	8.00	36	20			
44.533	44.534	PASSING_LANE	12	6	8.00	2.44	8.00	36	20			
44.621	44.622	PASSING_LANE	12	6	8.00	2.44	8.00	36	20			
44.632	44.633	PASSING_LANE	12	6	8.00	2.44	8.00	36	20			
44.641	44.642	PASSING_LANE	12	6	8.00	2.44	8.00	36	20			
44.651	44.653	PASSING_LANE	12	6	8.00	2.44	8.00	36	20			
44.655	44.656	PASSING_LANE	12	6	8.00	2.44	8.00	36	20			
44.658	44.659	PASSING_LANE	12	6	8.00	2.44	8.00	36	20			
44.661	44.662	PASSING_LANE	12	6	8.00	2.44	8.00	36	20			
44.664	44.665	PASSING_LANE	12	6	8.00	2.44	8.00	36	20			
44.667	44.668	PASSING_LANE	12	6	8.00	2.44	8.00	36	20			
44.670	44.671	PASSING_LANE	12	6	8.00	2.44	8.00	36	20			
44.673	44.674	PASSING_LANE	12	6	8.00	2.44	8.00	36	20			
44.675	44.676	PASSING_LANE	12	6	8.00	2.44	8.00	36	20			
44.681	44.682	PASSING_LANE	12	6	8.00	2.44	8.00	36	20			
44.683	44.684	PASSING_LANE	12	6	8.00	2.44	8.00	36	20			
44.692	44.693	PASSING_LANE	12	6	8.00	2.44	8.00	36	20			
44.695	44.696	PASSING_LANE	12	6	8.00	2.44	8.00	36	20			
44.701	44.702	PASSING_LANE	12	6	8.00	2.44	8.00	36	20			
44.823	44.824	PASSING_LANE	12	6	8.00	2.44	8.00	36	20			
44.825	44.826	PASSING_LANE	12	6	8.00	2.44	8.00	36	20			
44.836	44.838	PASSING_LANE	12	6	8.00	2.44	8.00	36	20			
44.839	44.840	PASSING_LANE	12	6	8.00	2.44	8.00	36	20			
44.842	44.844	PASSING_LANE	12	6	8.00	2.44	8.00	36	20			
44.847	44.848	PASSING_LANE	12	6	8.00	2.44	8.00	36	20			
44.850	44.851	PASSING_LANE	12	6	8.00	2.44	8.00	36	20			
44.854	44.855	PASSING_LANE	12	6	8.00	2.44	8.00	36	20			
44.857	44.858	PASSING_LANE	12	6	8.00	2.44	8.00	36	20			
44.858	44.860	PASSING_LANE	12	6	8.00	2.44	8.00	36	20			
44.861	44.862	PASSING_LANE	12	6	8.00	2.44	8.00	36	20			
44.864	44.887	PASSING_LANE	12	123	164.00	50.11	164.00	270	20	80	49	1.23
44.867	44.868	PASSING_LANE	12	6	8.00	2.44	8.00	36	20			
44.869	44.870	PASSING_LANE	12	6	8.00	2.44	8.00	36	20			
44.873	44.874	PASSING_LANE	12	6	8.00	2.44	8.00	36	20			
44.876	44.877	PASSING_LANE	12	6	8.00	2.44	8.00	36	20			
44.879	44.880	PASSING_LANE	12	6	8.00	2.44	8.00	36	20			
44.879	44.881	PASSING_LANE	12	6	8.00	2.44	8.00	36	20			
44.896	44.897	PASSING_LANE	12	6	8.00	2.44	8.00	36	20			
44.904	44.905	PASSING_LANE	12	6	8.00	2.44	8.00	36	20			
44.913	44.914	PASSING_LANE	12	6	8.00	2.44	8.00	36	20			
44.919	44.920	PASSING_LANE	12	6	8.00	2.44	8.00	36	20			
44.922	44.923	PASSING_LANE	12	6	8.00	2.44	8.00	36	20			
44.925	44.926	PASSING_LANE	12	6	8.00	2.44	8.00	36	20			
44.952	44.953	PASSING_LANE	12	6	8.00	2.44	8.00	36	20			
45.089	45.090	PASSING_LANE	12	6	8.00	2.44	8.00	36	20			
45.092	45.093	PASSING_LANE	12	6	8.00	2.44	8.00	36	20			
45.094	45.095	PASSING_LANE	12	6	8.00	2.44	8.00	36	20			
45.097	45.099	PASSING_LANE	12	6	8.00	2.44	8.00	36	20			
45.100	45.101	PASSING_LANE	12	6	8.00	2.44	8.00	36	20			
45.129	45.130	PASSING_LANE	12	6	8.00	2.44	8.00	36	20			
45.132	45.133	PASSING_LANE	12	6	8.00	2.44	8.00	36	20			
45.135	45.136	PASSING_LANE	12	6	8.00	2.44	8.00	36	20			
45.138	45.139	PASSING_LANE	12	6	8.00	2.44	8.00	36	20			
45.141	45.142	PASSING_LANE	12	6	8.00	2.44	8.00	36	20			
45.144	45.145	PASSING_LANE	12	6	8.00	2.44	8.00	36	20			
SUB TOTAL					660.00	201.39	660.00	2502	1260	80	49	1.23



THIS SHEET HAS BEEN
SIGNED, SEALED, AND DATED
ELECTRONICALLY.

DATE PREPARED
4/10/2024

ROUTE
I - 35

STATE
MO

DISTRICT
NW

SHEET NO.
3

COUNTY
CLINTON

JOB NO.
JNW0129

CONTRACT ID.

PROJECT NO.

BRIDGE NO.

DESCRIPTION

DATE
4/9/24

DESCRIPTION CHANGE.

DESCRIPTION CHANGE.

REMOVAL FOR FULL DEPTH REPAIRS,
UNBONDED CONCRETE OVERLAY

REVISÉD

PAVEMENT REPAIR NORTH BOUND SHEET 6

PAVEMENT REPAIR NORTH BOUND SHEET 6													
LOG MILE		LOCATION	WIDTH	LENGTH	1	REMOVED FOR PARTIAL DEPTH PAVEMENT REPAIR	FURNISHING AND PLACING CONCRETE MATERIAL	UNBONDED CONCRETE OVERLAY INTERLAYER	SAW CUTS INTERIAL AND PERIMETER	DOWEL BAR (DRILLING, FURNISHING, AND INSTALLATION EACH	DOWEL BAR (FURNISHING AND INSTALLATION WITH BASKETS) EACH	TIE BAR (DRILLING, FURNISHING AND INSTALLATION) EACH	PORTLAND CEMENT CONCRETE SHOULDER RUMBLE STRIP STA.
					1	S.Y.	C.Y.	S.Y.	L.F.				
46.216	46.218	PASSING_LANE	12	6		8.00	2.44	8.00	36	20			
46.248	46.249	PASSING_LANE	12	6		8.00	2.44	8.00	36	20			
46.338	46.339	PASSING_LANE	12	6		8.00	2.44	8.00	36	20			
46.339	46.340	PASSING_LANE	12	6		8.00	2.44	8.00	36	20			
46.342	46.344	PASSING_LANE	12	6		8.00	2.44	8.00	36	20			
46.345	46.346	PASSING_LANE	12	6		8.00	2.44	8.00	36	20			
46.348	46.349	PASSING_LANE	12	6		8.00	2.44	8.00	36	20			
46.353	46.354	PASSING_LANE	12	6		8.00	2.44	8.00	36	20			
46.356	46.357	PASSING_LANE	12	6		8.00	2.44	8.00	36	20			
46.367	46.368	PASSING_LANE	12	6		8.00	2.44	8.00	36	20			
46.373	46.374	PASSING_LANE	12	6		8.00	2.44	8.00	36	20			
46.378	46.379	PASSING_LANE	12	6		8.00	2.44	8.00	36	20			
46.381	46.382	PASSING_LANE	12	6		8.00	2.44	8.00	36	20			
46.427	46.429	PASSING_LANE	12	6		8.00	2.44	8.00	36	20			
46.436	46.437	PASSING_LANE	12	6		8.00	2.44	8.00	36	20			
46.450	46.451	PASSING_LANE	12	6		8.00	2.44	8.00	36	20			
46.453	46.454	PASSING_LANE	12	6		8.00	2.44	8.00	36	20			
46.455	46.456	PASSING_LANE	12	6		8.00	2.44	8.00	36	20			
46.458	46.460	PASSING_LANE	12	6		8.00	2.44	8.00	36	20			
46.464	46.465	PASSING_LANE	12	6		8.00	2.44	8.00	36	20			
46.473	46.474	PASSING_LANE	12	6		8.00	2.44	8.00	36	20			
46.476	46.477	PASSING_LANE	12	6		8.00	2.44	8.00	36	20			
46.477	46.478	PASSING_LANE	12	6		8.00	2.44	8.00	36	20			
46.481	46.482	PASSING_LANE	12	6		8.00	2.44	8.00	36	20			
46.483	46.484	PASSING_LANE	12	6		8.00	2.44	8.00	36	20			
46.487	46.488	PASSING_LANE	12	6		8.00	2.44	8.00	36	20			
46.488	46.489	PASSING_LANE	12	6		8.00	2.44	8.00	36	20			
46.494	46.495	PASSING_LANE	12	6		8.00	2.44	8.00	36	20			
46.497	46.498	PASSING_LANE	12	6		8.00	2.44	8.00	36	20			
46.500	46.501	PASSING_LANE	12	6		8.00	2.44	8.00	36	20			
46.504	46.505	PASSING_LANE	12	6		8.00	2.44	8.00	36	20			
46.519	46.520	PASSING_LANE	12	6		8.00	2.44	8.00	36	20			
46.536	46.537	PASSING_LANE	12	6		8.00	2.44	8.00	36	20			
46.538	46.540	PASSING_LANE	12	6		8.00	2.44	8.00	36	20			
46.561	46.562	PASSING_LANE	12	6		8.00	2.44	8.00	36	20			
46.564	46.566	PASSING_LANE	12	6		8.00	2.44	8.00	36	20			
46.567	46.568	PASSING_LANE	12	6		8.00	2.44	8.00	36	20			
46.579	46.580	PASSING_LANE	12	6		8.00	2.44	8.00	36	20			
46.587	46.589	PASSING_LANE	12	6		8.00	2.44	8.00	36	20			
46.603	46.605	PASSING_LANE	12	6		8.00	2.44	8.00	36	20			
46.615	46.616	PASSING_LANE	12	6		8.00	2.44	8.00	36	20			
46.624	46.625	PASSING_LANE	12	6		8.00	2.44	8.00	36	20			
46.647	46.648	PASSING_LANE	12	6		8.00	2.44	8.00	36	20			
46.650	46.651	PASSING_LANE	12	6		8.00	2.44	8.00	36	20			
46.653	46.654	PASSING_LANE	12	6		8.00	2.44	8.00	36	20			
46.658	46.659	PASSING_LANE	12	6		8.00	2.44	8.00	36	20			
46.660	46.661	PASSING_LANE	12	6		8.00	2.44	8.00	36	20			
46.663	46.664	PASSING_LANE	12	6		8.00	2.44	8.00	36	20			
46.665	46.666	PASSING_LANE	12	6		8.00	2.44	8.00	36	20			
46.669	46.670	PASSING_LANE	12	6		8.00	2.44	8.00	36	20			
46.672	46.673	PASSING_LANE	12	6		8.00	2.44	8.00	36	20			
46.674	46.676	PASSING_LANE	12	6		8.00	2.44	8.00	36	20			
46.675	46.676	PASSING_LANE	12	6		8.00	2.44	8.00	36	20			
46.679	46.681	PASSING_LANE	12	6		8.00	2.44	8.00	36	20			
46.680	46.682	PASSING_LANE	12	6		8.00	2.44	8.00	36	20			
46.686	46.688	PASSING_LANE	12	6		8.00	2.44	8.00	36	20			
46.726	46.727	PASSING_LANE	12	6		8.00	2.44	8.00	36	20			
46.727	46.728	PASSING_LANE	12	6		8.00	2.44	8.00	36	20			
46.731	46.732	PASSING_LANE	12	6		8.00	2.44	8.00	36	20			
46.737	46.738	PASSING_LANE	12	6		8.00	2.44	8.00	36	20			
46.739	46.740	PASSING_LANE	12	6		8.00	2.44	8.00	36	20			
46.743	46.744	PASSING_LANE	12	6		8.00	2.44	8.00	36	20			
46.745	46.746	PASSING_LANE	12	6		8.00	2.44	8.00	36	20			
				SUB TOTAL		504.00	153.72	504.00	2268	1260	0	0	0

SUMMARY OF QUANTITIES
SHEET 15 OF 19




DATE PREPARED	
4/10/2024	
ROUTE	STATE
I - 35	MO
DISTRICT	SHEET NO.
NW	3
COUNTY	
CLINTON	
JOB NO.	
JNW0129	
CONTRACT ID.	

PROJECT NO.
BRIDGE NO.

[illegible]

MISSOURI HIGHWAYS AND TRANSPORTATION
COMMISSION

105 WEST CAPITOL
JEFFERSON CITY, MO 65102
1-888-ASK-MODOT (1-888-275-6636)

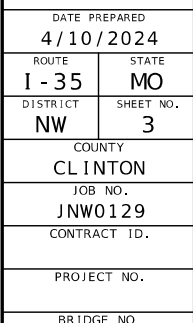

DATE	DESCRIPTION
4/19/24	DESCRIPTION CHANGE.



MISSOURI HIGHWAYS AND TRANSPORTATION
COMMISSION

105 WEST CAPITOL
JEFFERSON CITY, MO 65102
1-888-ASK-MODOT (1-888-275-6636)



PAVEMENT REPAIR TOTALS								
	REMOVAL FOR PARTIAL DEPTH PAVEMENT REPAIR	FURNISHING AND PLACING CONCRETE MATERIAL	UNBONDED CONCRETE OVERLAY INTERLAYER	SAW CUTS INTERNAL AND PERIMETER	DOWEL BAR (DRILLING, FURNISHING, AND INSTALLATION	DOWEL BAR (FURNISHING AND INSTALLATION WITH BASKETS)	TIE BAR (DRILLING, FURNISHING AND INSTALLATION)	PORTLAND CEMENT CONCRETE SHOULDER RUMBLE STRIP
SHEET	S.Y.	C.Y.	S.Y.	L.F.	EACH	EACH	EACH	STA.
DRIVING 1	919.16	280.82	919.16	3,002.00	1,180.00	140.00	84.00	2.81
DRIVING 2	667.19	203.84	667.19	2,422.00	1,100.00	20.00	13.00	2.00
DRIVING 3	1,519.61	464.30	1,519.61	4,154.00	1,280.00	340.00	214.00	6.81
DRIVING 4	1,312.71	401.05	1,312.71	3,848.00	1,260.00	300.00	190.00	5.00
DRIVING 5	2,652.06	810.31	2,652.06	6,094.00	1,180.00	860.00	541.00	14.41
DRIVING 6	1,774.65	542.12	1,774.65	4,822.00	1,180.00	620.00	396.00	0.00
DRIVING 7	1,349.34	412.08	1,349.34	3,956.00	1,180.00	430.00	274.00	0.00
DRIVING 8	916.00	279.65	916.00	3,030.00	1,180.00	200.00	129.00	0.00
DRIVING 9	1,104.00	337.10	1,104.00	3,444.00	1,180.00	310.00	188.00	0.00
DRIVING 10	438.67	133.95	438.67	1,354.00	460.00	120.00	72.00	0.00
PASSING 1	252.00	76.91	252.00	966.00	460.00	30.00	20.00	0.63
PASSING 2	506.67	154.54	506.67	2,272.00	1,260.00	0.00	0.00	0.08
PASSING 3	504.00	153.72	504.00	2,268.00	1,260.00	0.00	0.00	0.00
PASSING 4	660.00	201.39	660.00	2,502.00	1,260.00	80.00	49.00	1.23
PASSING 5	516.00	157.39	516.00	2,286.00	1,260.00	0.00	0.00	0.00
PASSING 6	504.00	153.72	504.00	2,268.00	1,260.00	0.00	0.00	0.00
PASSING 7	504.00	153.72	504.00	2,268.00	1,260.00	0.00	0.00	0.00
PASSING 8	841.33	256.80	841.33	3,002.00	1,280.00	170.00	108.00	2.71
SUBTOTALS	16,941.39	5,173.41	16,941.39	53,958.00	20,480.00	3,620.00	2,278.00	35.68
PAY TOTALS	16,941.4	5,173.4	16,941.4	53,958.00	20,480.00	3,620.00	2,278.00	35.7

MOBILIZATION
LUMP SUM = 1

AGGREGATE & COMPACTION	
TYPE 1 & 5	SUBGRADE
AGGREGATE	COMPACTION
SY.	SY.
438	44

SUMMARY OF QUANTITIES
SHEET 18 OF 19

STATE OF MISSOURI

RICHARD W. ORR

NUMBER

PE-2002003397

PROFESSIONAL ENGINEER

THIS SHEET HAS BEEN
SIGNED, SEALED AND DATED
ELECTRONICALLY.


DATE PREPARED	
4/10/2024	
ROUTE	STATE
I - 35	MO
DISTRICT	SHEET NO.
NW	4
COUNTY	
CLINTON	
JOB NO.	
JNW0129	
CONTRACT ID.	
PROJECT NO.	
BRIDGE NO.	

DATE	DESCRIPTION
4/9/24	DESCRIPTION CHANGE.

MISSOURI HIGHWAYS AND TRANSPORTATION
COMMISSION

105 WEST CAPITOL
JEFFERSON CITY, MO 65102
1-888-ASK-MODOT (1-888-275-6636)

MoDOT

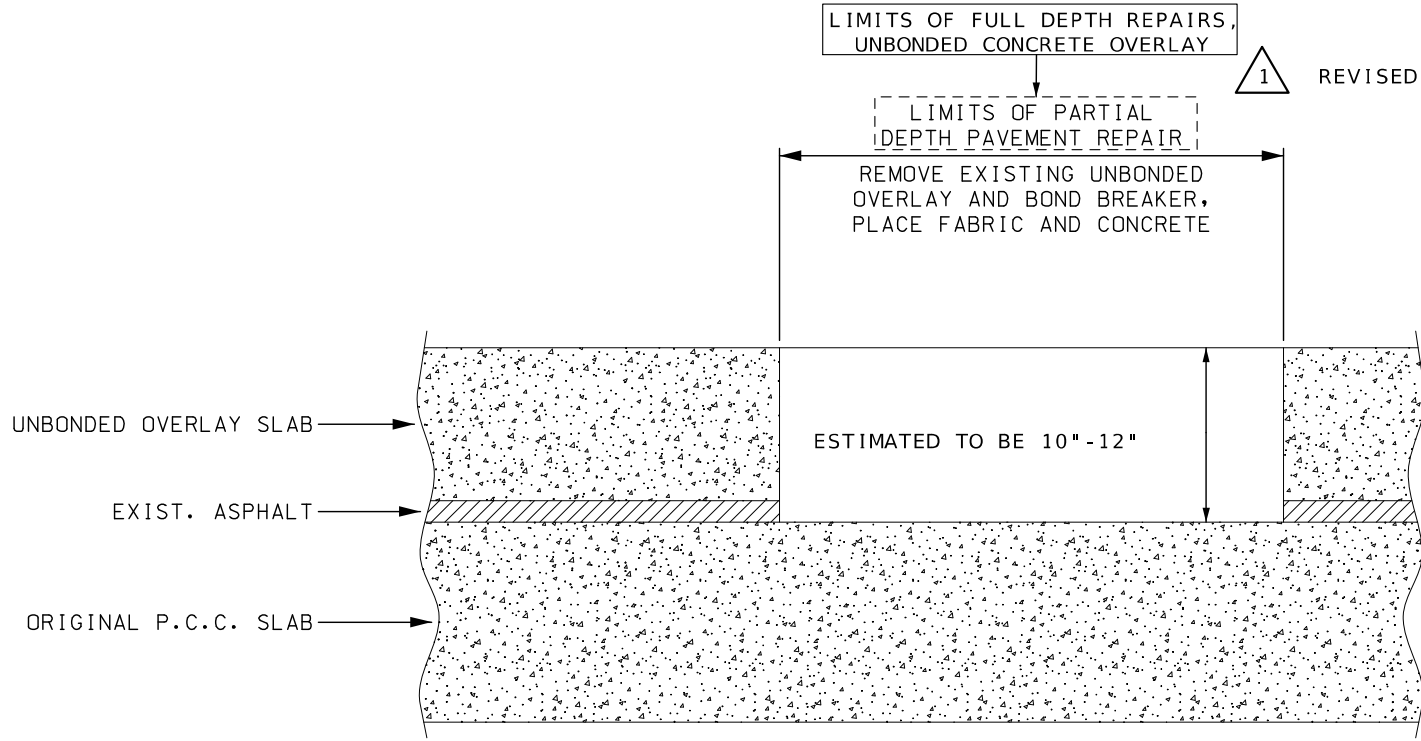

FULL DEPTH REPAIRS, UNBONDED CONCRETE OVERLAY DETAIL

PARTIAL DEPTH PAVEMENT REPAIR DETAIL

(SECTION VIEW)

NOT TO SCALE

REPAIR DETAILS
SPECIAL SHEET 1 OF 1